
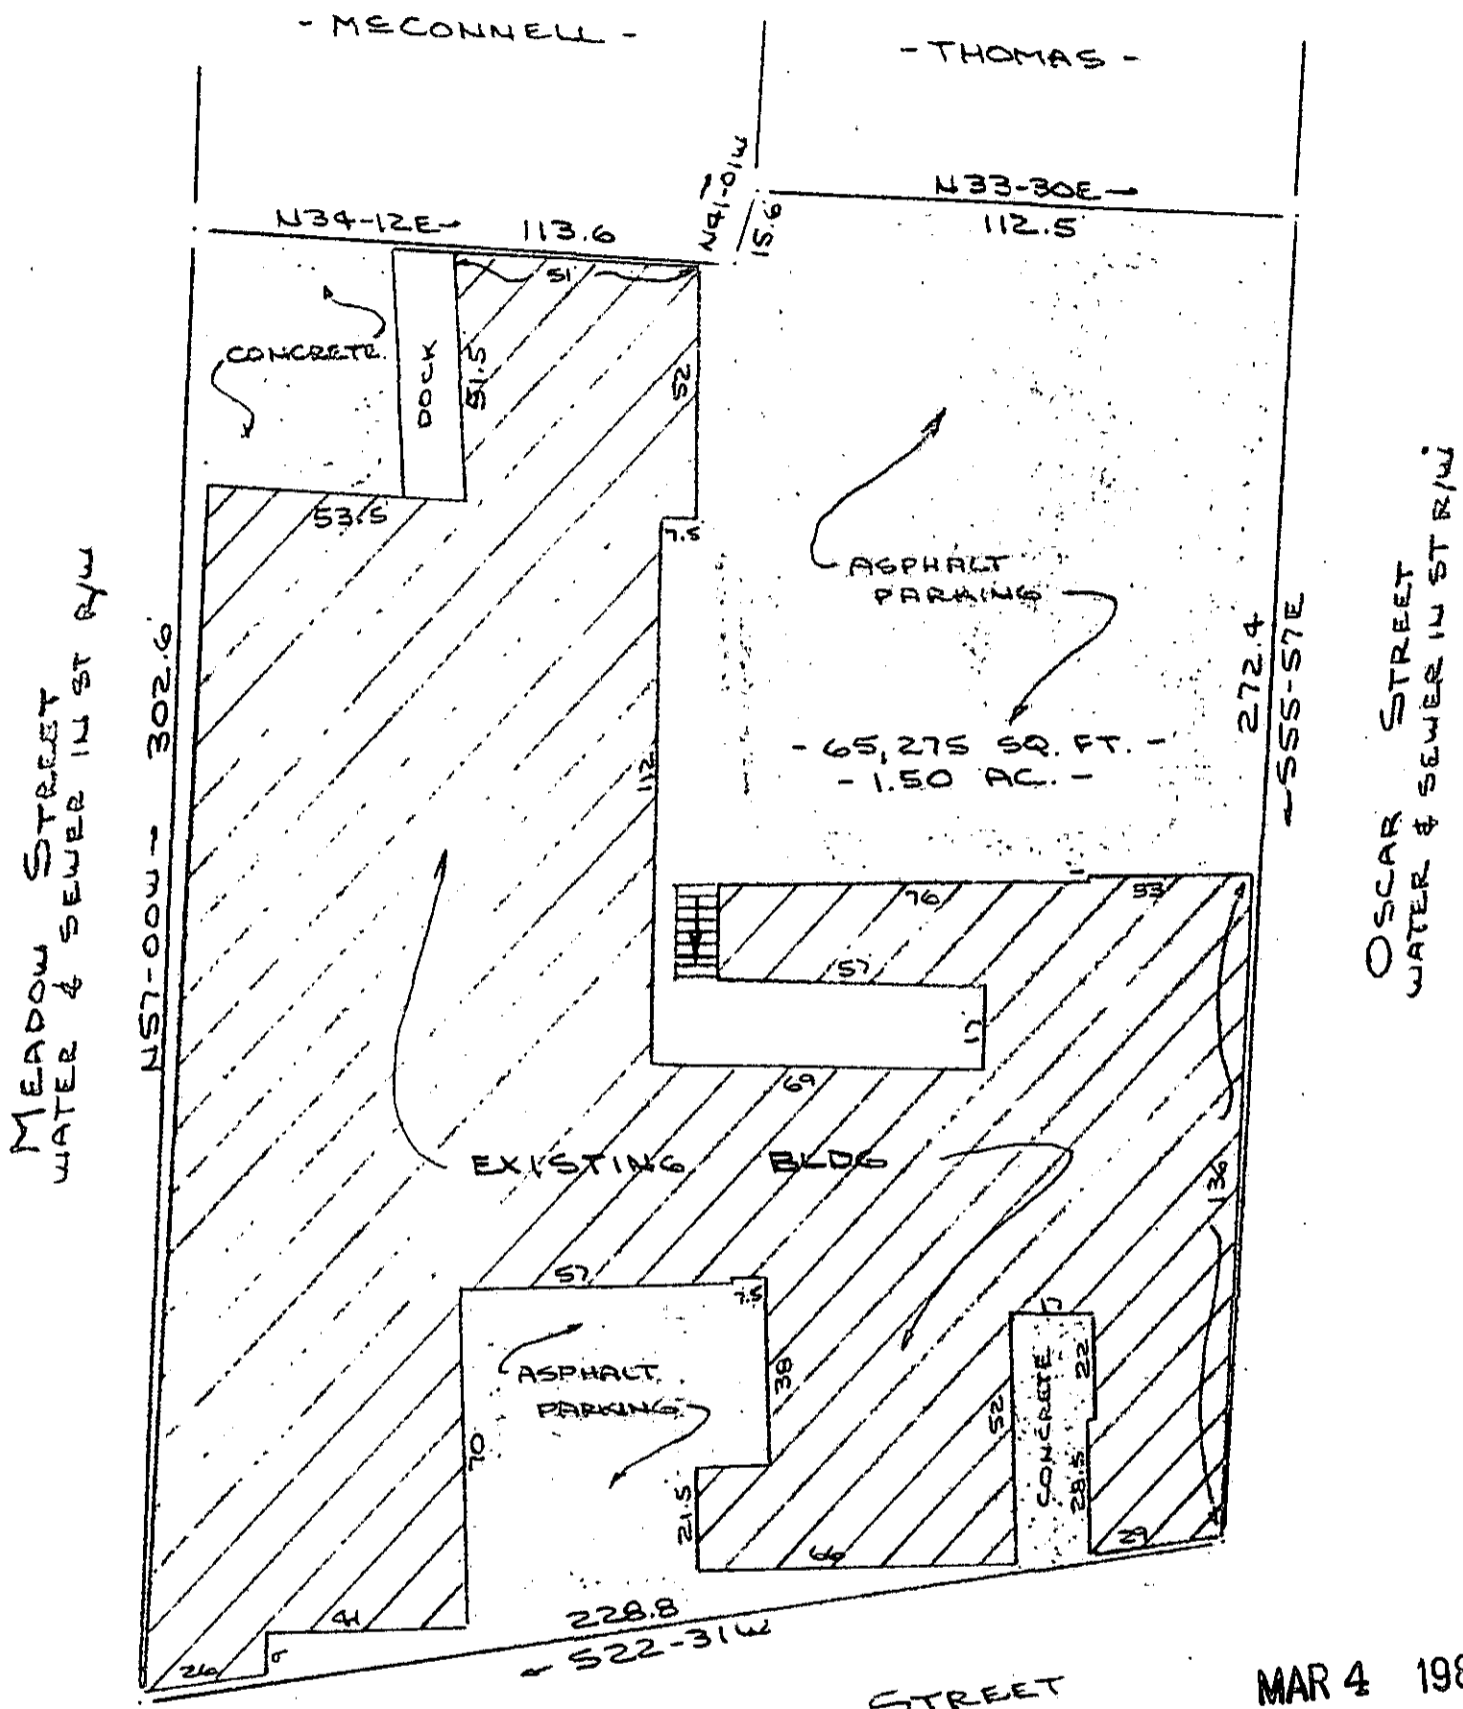


FILED
GREENVILLE CO. S. C.

MAR 4 3 16 PM '81

Note:
Improvements or
lot are not in a
flood hazard area.

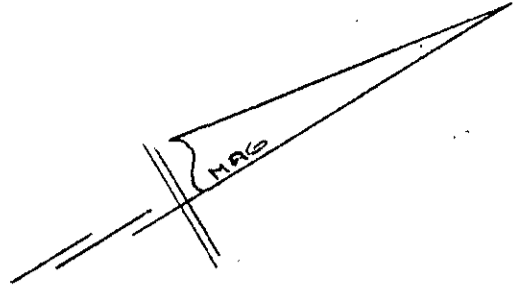

SOUTH HUDSON STREET
WATER & SEWER IN ST R/W

MAR 4 1981

J-M-4

PROPERTY OF
FRANCESCO PANEBIANCO
GREENVILLE, S. C.
SCALE: 1"=40' 26 JAN 1981

21796

This is to certify that on the 26th day of January, 1981, I surveyed the property shown on this plat, being known as PROPERTY OF FRANCESCO PANEBIANCO and recorded in the REC Office Greenville County, S. C., in Plat Book _____ at Page _____; and that the property lines, walls and buildings are as shown hereon, and that the walls and buildings located on said lot do not encroach or project on adjacent street or property, and that no adjacent walls or buildings encroach or project on said premises, and no power lines cross this property except as shown hereon.

R. B. Bruce
R. B. Bruce, RLS #1952
SOUTH CAROLINA SURVEYOR
GREENVILLE

CAROLINA SURVEYING CO.
112 Manly St.
Greenville, S. C. 29601
MAR 4 1981 1096