AF 10505

MICROFILMED

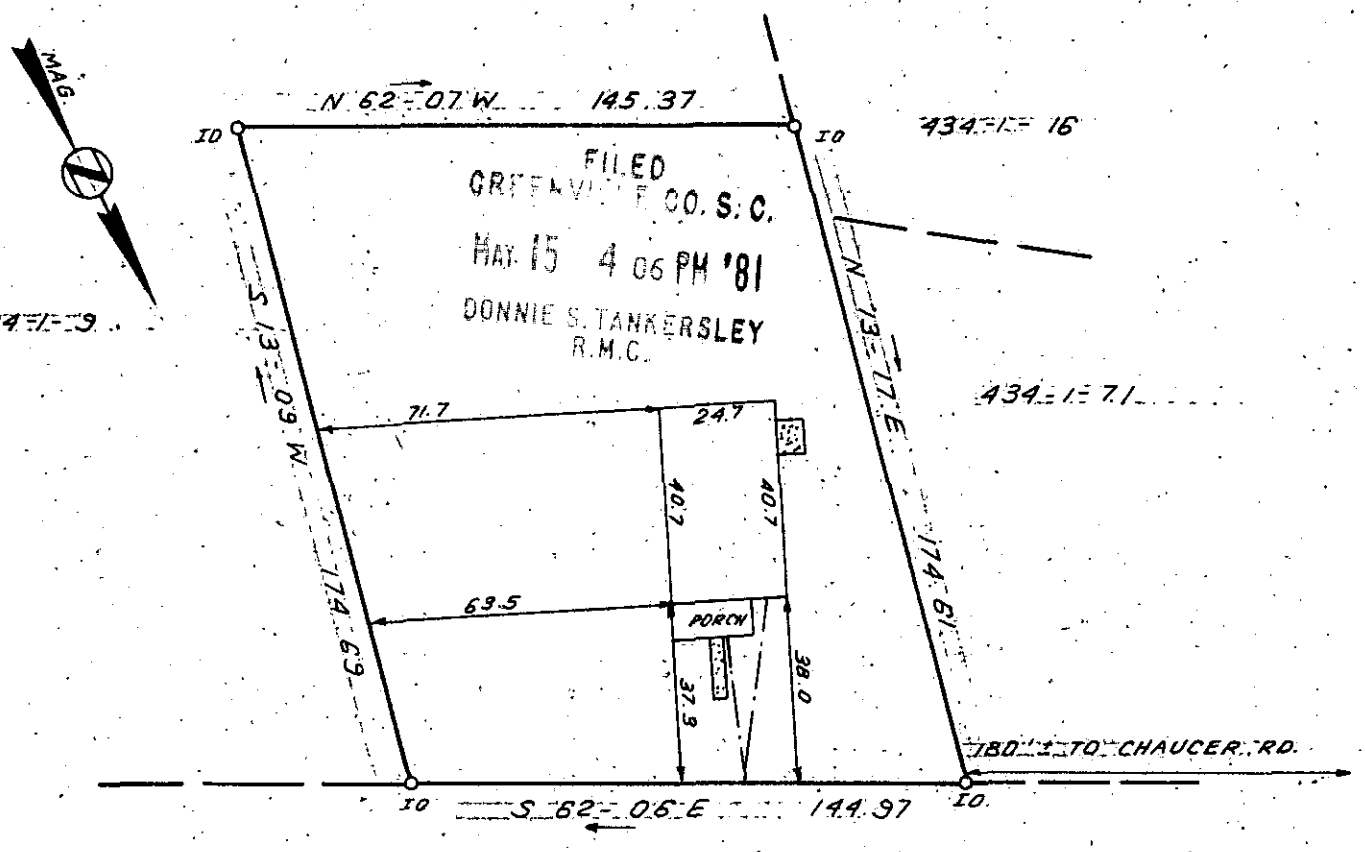


THOMPSON ROAD

This is to certify that on April 16, 1981, I surveyed the property shown on this plat, known as Tract 66 on plat of Parker Land Co., recorded in the RMC Office of Greenville County in Deed Book 157 on page 194, and that the property lines, walls and buildings are as shown hereon; that the building located on said lot does not encroach or project on adjacent streets or property, and that no adjacent walls or buildings encroach or project on said premises, and that no utility lines cross this property except as shown hereon. This property is not located in a designated flood hazard area.

James R. Freeland

James R. Freeland RLS & PE 4781

Note: Also known as portion of property shown in Deed Book 1130 on page 492.

8-10-81

32004

40 0 40 80
scale feet

434-1-8

SOUTH CAROLINA REGISTERED LAND SURVEYOR NO. 4791 JAMES RALPH FREELAND

SEAL

**STATE OF SOUTH CAROLINA**
**GREENVILLE COUNTY**

PARKER LAND CO.
TRACT 66
PROPERTY OF
WILLIAM W. WESTMORELAND
FRANCES S. WESTMORELAND

**FREELAND & ASSOCIATES**
*Engineers • Land Surveyors*
GREENVILLE, S.C.

| | |
|---|---|
| SURVEY | WBH III |
| DRAWN | B.R. |
| CHECK | M.C. |
| SCALE | 1"=40' |
| DATE | APRIL 16.81 |
| DWG. NO. | 6382 |

PRINT MACHINE INC.

3.00 3 12721A01