


FILED
GREENVILLE CO. S.C.
MAY 10 12 51 PM '81
DONALD F. WAGGONER
R.M.C.

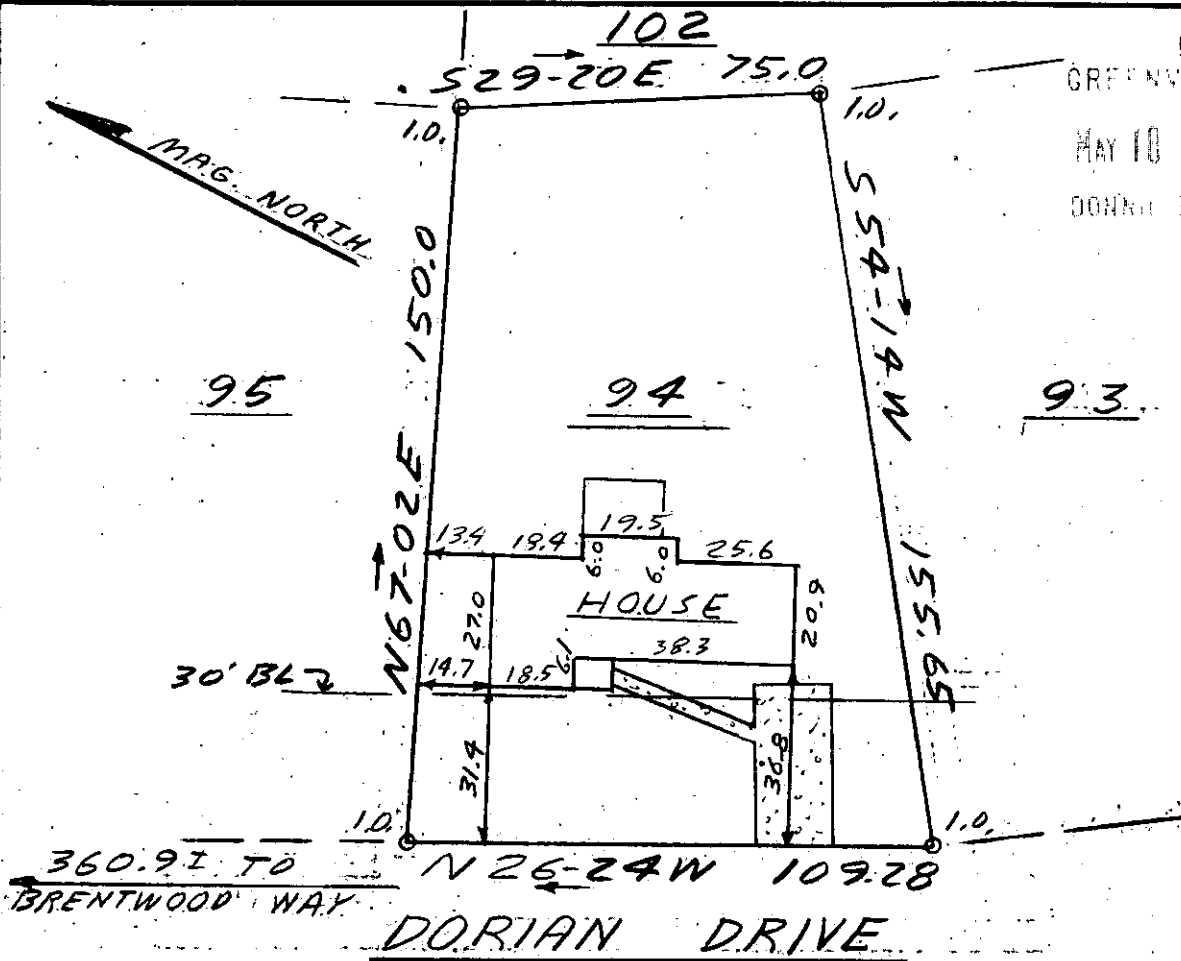

This is to certify that on May 11, 1981, I surveyed the property shown on this plat, known as Lot 94 on plat of Brentwood Sec. III, recorded in the RMC Office of Greenville County in Plat Book 5D on page 42, and that the property lines, walls and buildings are as shown hereon; that the building located on said lot does not encroach or project on adjacent streets or property, and that no adjacent walls or buildings encroach or project on said premises, and that no utility lines cross this property except as shown hereon. This property is not located in a designated flood hazard area.

5' drainage and utility easement each side of all side and rear lot lines.

James R. Freeland
James R. Freeland RLS & PE 4781

✓ 80.85

32179



STATE OF SOUTH CAROLINA
GREENVILLE COUNTY

BRENTWOOD
SECT. III - LOT 94
PROPERTY OF
DONALD F. WAGGONER

FREELAND & ASSOCIATES
Engineers • Land Surveyors
GREENVILLE, S.C.

SURVEY M.C.
DRAWN J.R.F.
CHECK M.L.C.
SCALE 1" = 40'
DATE 5-11-81
DWG. NO. 81-6457