


REVISED: 4-21-81

MAY 25 1981 32704

This is to certify that on December 15, 1980, I surveyed the property shown on this plat, known as Pt. 9 on plat of Windsor Oaks Sec. 1, recorded in the RMC Office of Greenville County in Plat Book 7C on page 8, and that the property lines, walls and buildings are as shown hereon; that the building located on said lot does not encroach or project on adjacent streets or property, and that no adjacent walls or buildings encroach or project on said premises, and that no utility lines cross this property except as shown hereon. This property is not located in a designated flood hazard area.

5' drainage and utility easement along all side and rear lot lines.

James R. Freeland
James R. Freeland RLS & PE 4781

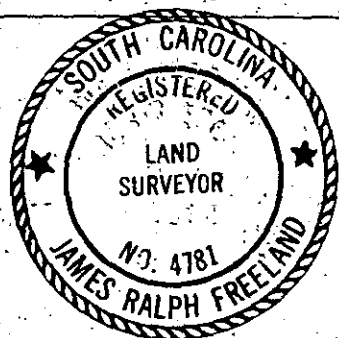

STATE OF SOUTH CAROLINA
GREENVILLE COUNTY

WINDSOR OAKS
SEC. 1 - PART LOT 9
PROPERTY OF
JERRY ALEXANDER

FREELAND & ASSOCIATES
Engineers • Land Surveyors

GREENVILLE, S.C.

SURVEY *MC*
DRAWN *MC*
CHECK *MC*
SCALE 1" = 40'
DATE 12-15-80
DWG. NO. 80-6025