
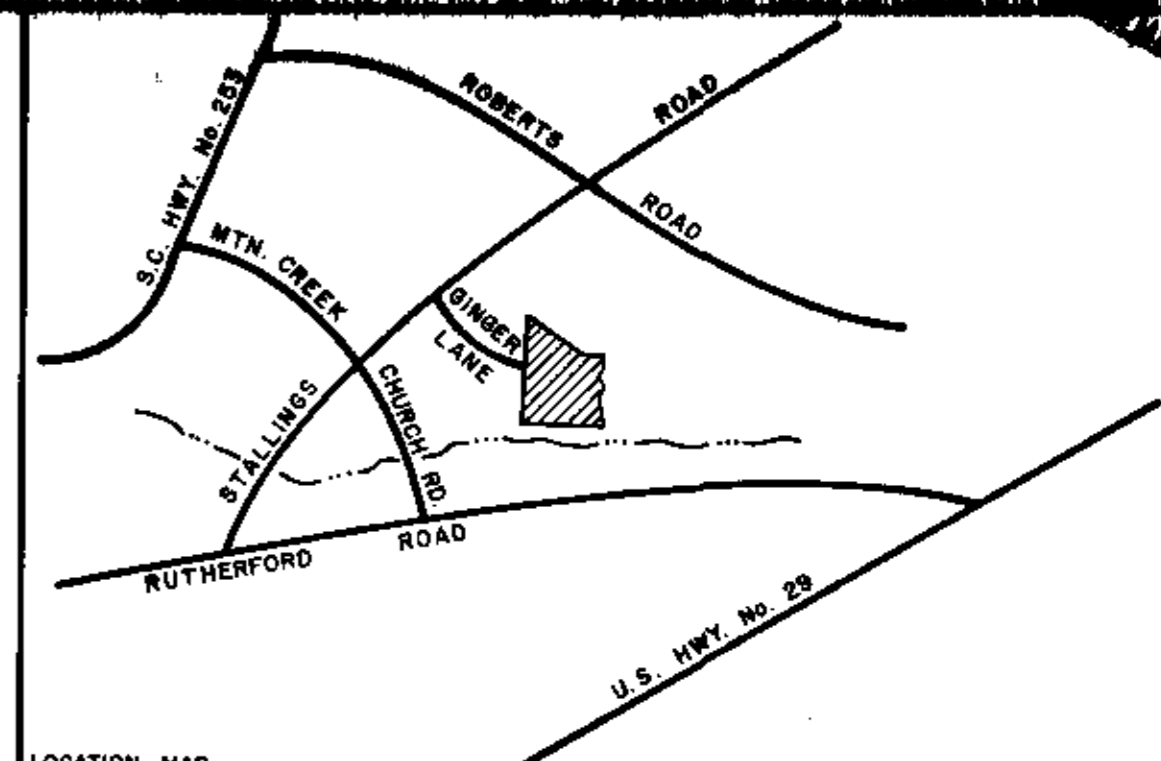


FILED
 FEB 13 3 15 PM '82
 DONNA W. HANFERSLEY
 S.C.

NUMBER	BEARING	CHORD	ARC	RADIUS
(1)	N 36-03W	43.04'	43.11'	225.00'
(2)	N 46-04W	35.40'	35.44'	225.00'
(3)				
(4)	N 49-51W	1.24'	1.24'	50.00'
(5)	N 23-46W	42.86'	44.29'	50.00'
(6)	N 51-23E	76.35'	86.88'	50.00'
(7)	S 41-51E	60.17'	64.56'	50.00'
(8)	S 17-17W	37.69'	38.64'	50.00'
(9)	S 45-05E	52.59'	52.67'	275.00'
(10)	S 35-05E	43.27'	43.31'	275.00'
(11)				

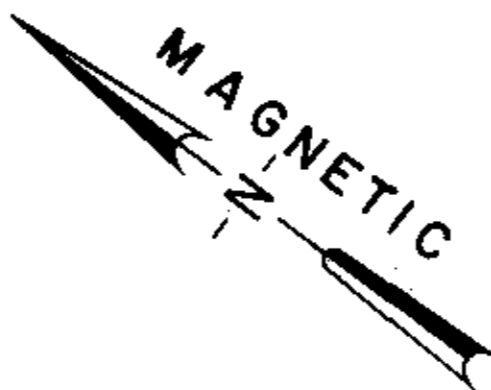


NOTE: FLOOD PLAIN DATA SHOWN ON THIS DRAWING SUPPLIED TO THIS OFFICE BY CORPS OF ENGINEERS.


T.B.M. C-2 ELEV. 921.612, YELLOW PAINTED CHISELED SQUARE ON UPSTREAM RIGHT CORNER OF BRIDGE CURB AT STALLINGS RD. AND MOUNTAIN CREEK. T.B.M. BASED ON U.S.G.S. VERTICAL DATUM.

IRON PINS AT ALL CORNERS UNLESS OTHERWISE NOTED.

THERE IS A 5' DRAINAGE AND UTILITY EASEMENT ON BOTH SIDES OF ALL SIDE AND REAR LOTS WITH EXCEPTION OF ALL ZERO LOT LINES AS NOTED BELOW.

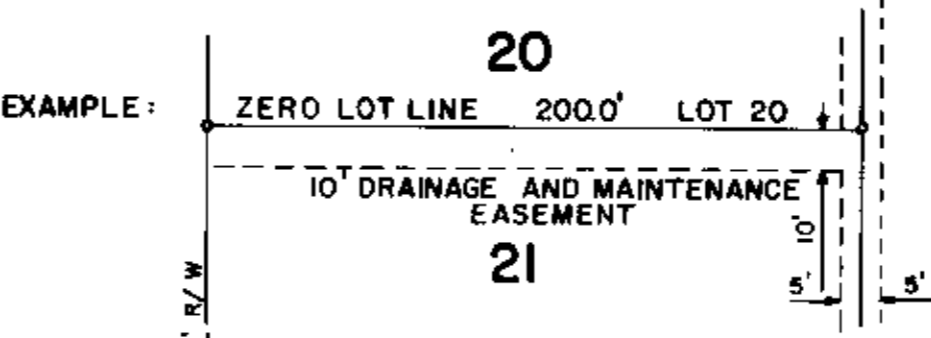

J.P. 59V

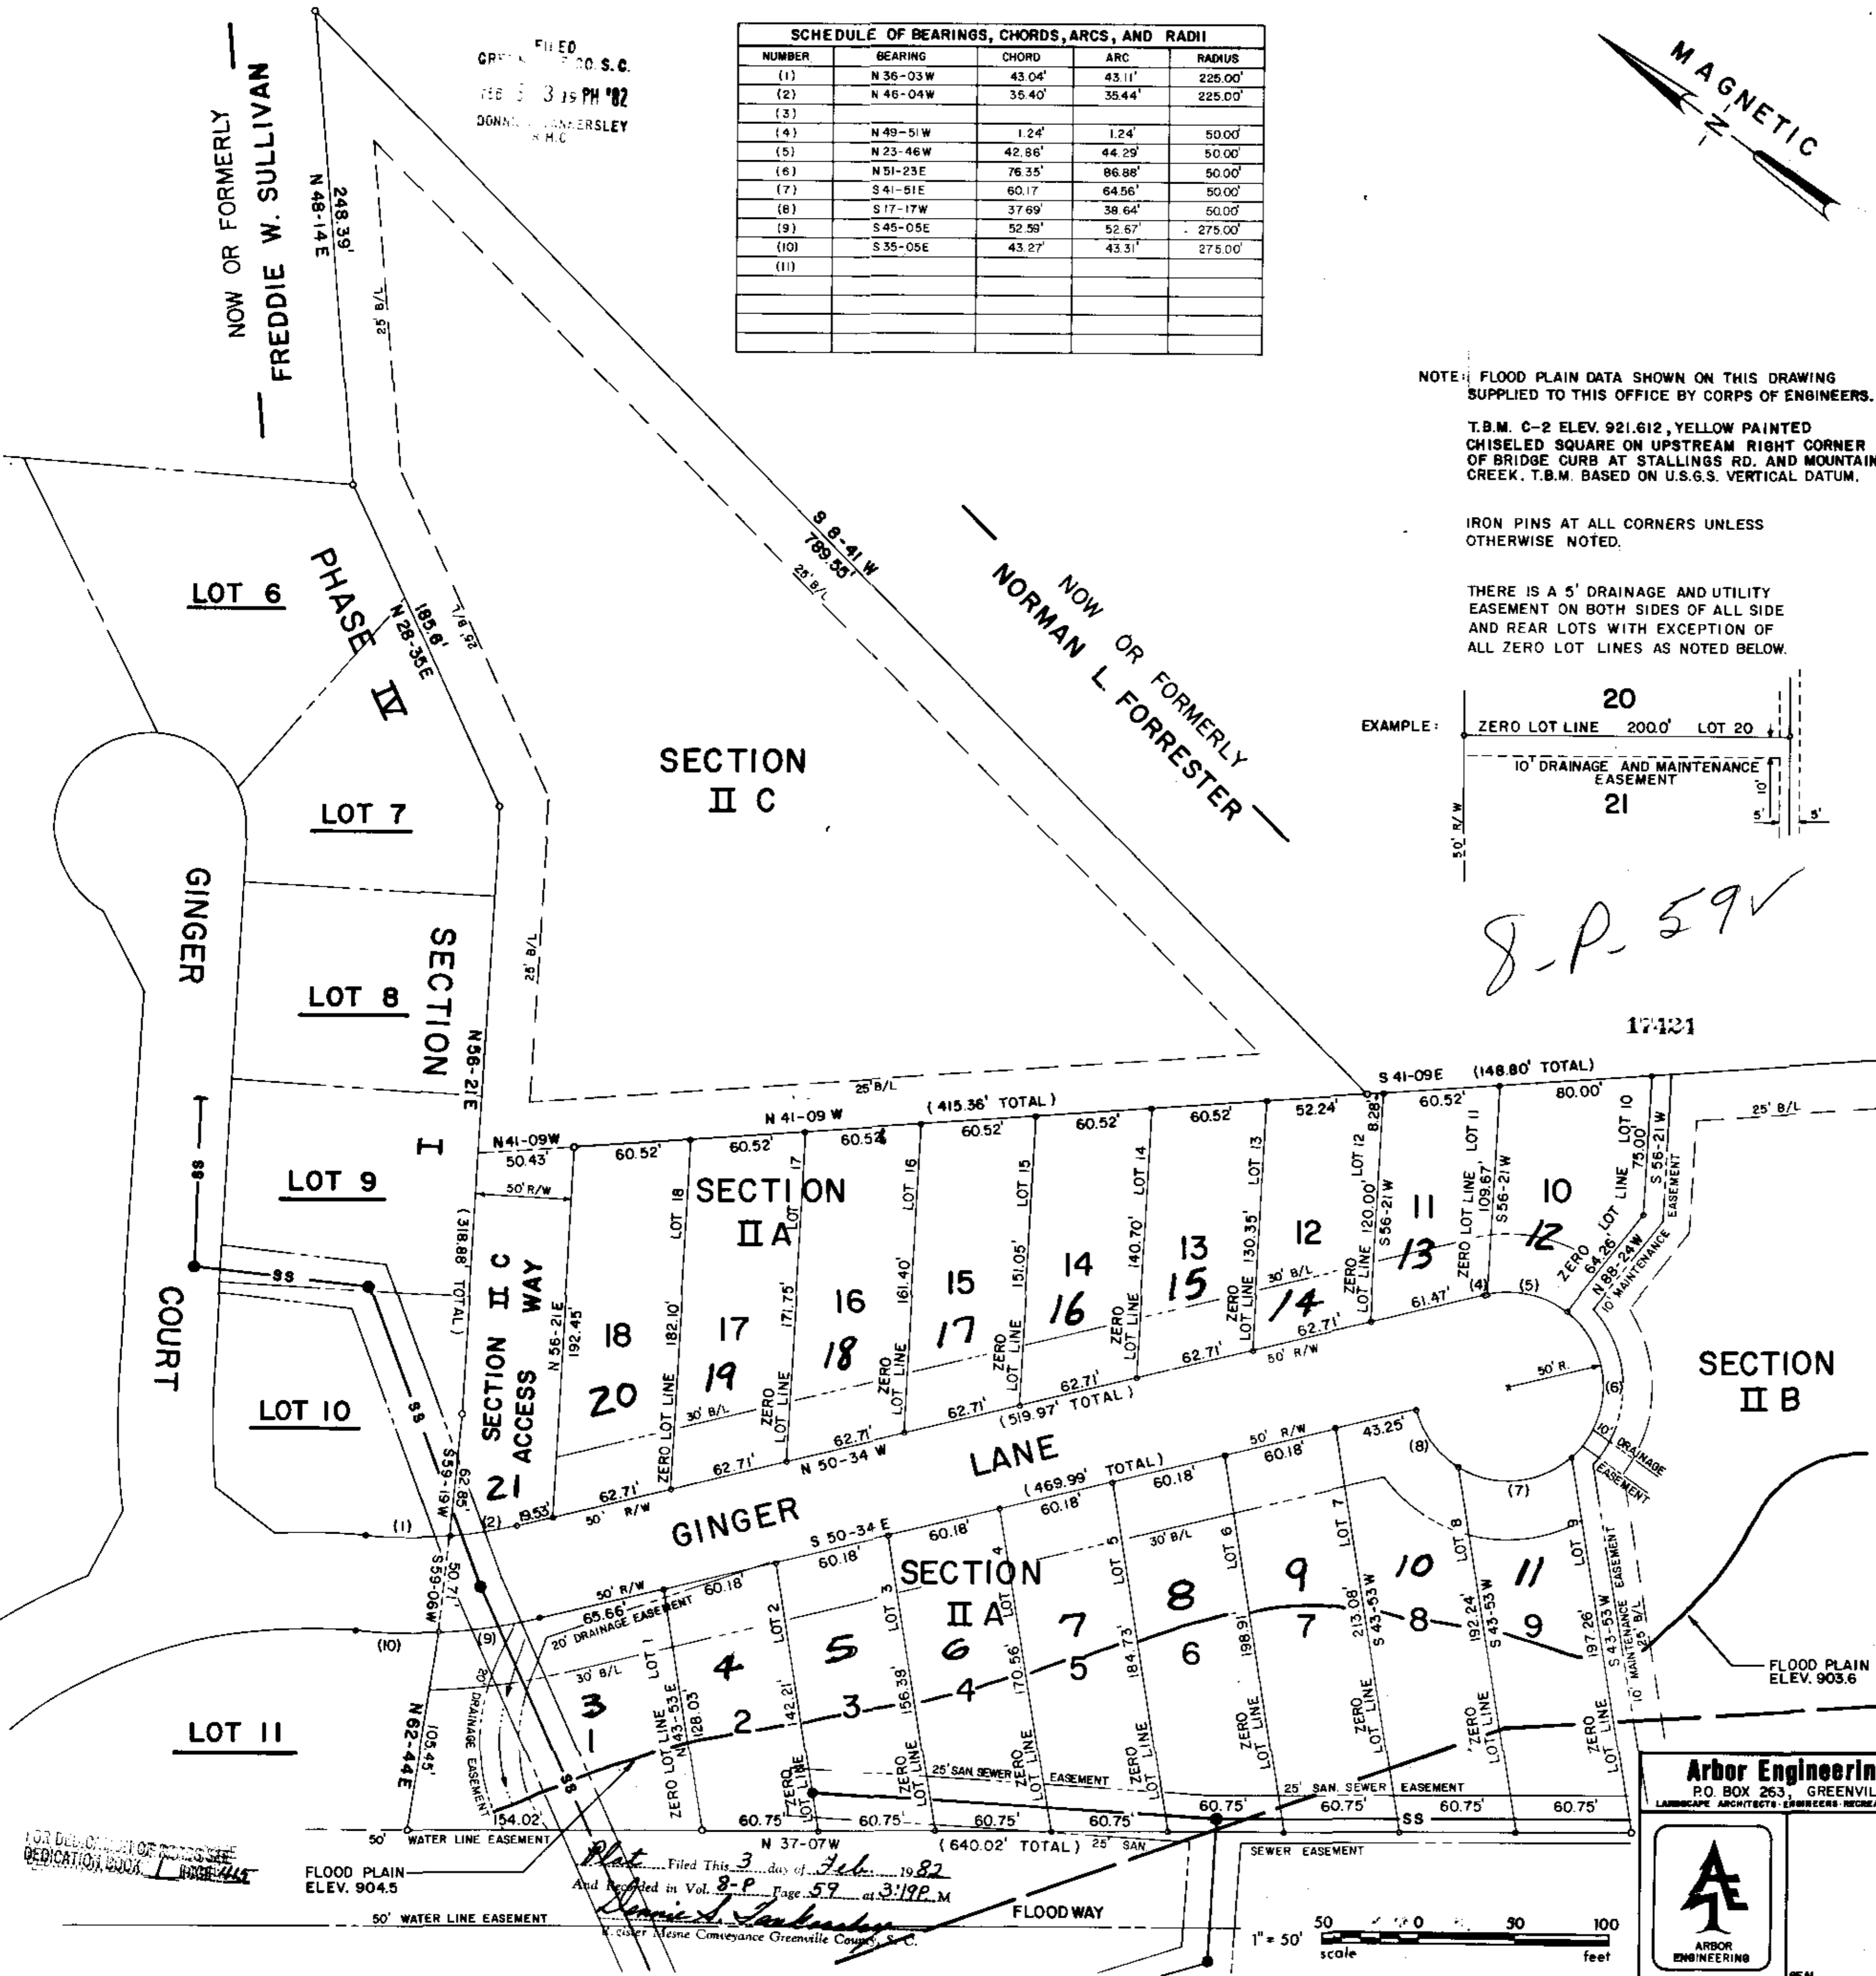

FINAL PLAT

CERTIFICATE OF OWNERSHIP AND DEDICATION

"The undersigned hereby acknowledge that I am less and the owner(s) of the property shown and described herein and that I (we) hereby adapt this plan of subdivision with my (our) best consent and that I (we) establish the minimum building restriction lines, and hereby dedicate to public use as roads, streets, and easements, forever all areas so shown or indicated on said plat.

2/16/82 _____ Signed _____
 _____ Signed _____
 _____ Signed _____
 _____ Signed _____

CERTIFICATE OF ACCURACY

"I, William N. Skardon, certify that this plat was (drawn by and) shown under my supervision (an actual survey made under my supervision) from an actual survey made by me (detailed description recorded in Book _____, Page _____, Book _____, Page _____, etc.) (other); that the error of closure as calculated by latitude and departure is 1:10000; that the boundaries not surveyed are shown as broken lines plotted from information found in Book _____, Page _____; that this plat was prepared in accordance with the Greenville County Subdivision Regulations as adopted.

13 FEB 1981 DATE
 William N. Skardon LICENSED ENGINEER OR REGISTERED SURVEYOR
 S. C. Registration No. 7261

CERTIFICATE OF APPROVAL FOR RECORDING

"I hereby certify that the subdivision plat shown herein has been found to comply with the Subdivision Regulations for Greenville County, with the exception of such variances, if any, as are noted in the minutes of the Greenville County Planning Commission of Greenville County, South Carolina, and that it has been approved for recording in the office of the County Register of Deeds Conveyance.

2/3/82 DATE
 James Forbes DIRECTOR OF PLANNING
 GREENVILLE COUNTY PLANNING COMMISSION

FILE NUMBER
80-130
 (12) 276-526-2-1-3 THRU 21
 out of 526-2-1-2

PEBBLECREEK P.U.D.
 PHASE IX
 SECTION II A & SECTION II C


PEBBLECREEK DEVELOPMENT OWNER ARBOR ENGINEERING, INC. SURVEYOR

NO. OF ACRES 8.50 MILES NEW ROAD 0.14
 NO. OF LOTS 18 DATE: 11 FEB 1981

GREENVILLE SOUTH CAROLINA
 WNS RHF RHF DATE 11 FEB 1981
 SCALE 1"=50' FILE 80029

Arbor Engineering, Inc.
 P.O. BOX 263, GREENVILLE, S.C.
 LANDSCAPE ARCHITECTS ENGINEERS DECORATIVE PLANNERS

ARBOR ENGINEERING

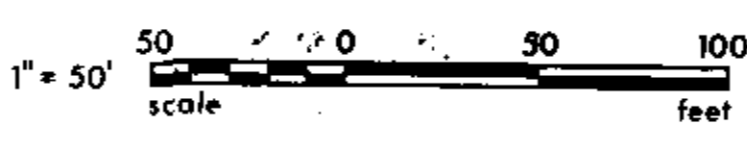

RECORDING FEE PAID \$5.00

FOR DEED BOOK OR RECORDS DEED BOOK 1 PAGE 445

FLOOD PLAIN ELEV. 904.5

Plat Filed This 3 day of Feb. 1982
 And Registered in Vol. 8-P Page 59 at 3:19P.M.
 James S. Skardon
 County Clerk Greenville County, S.C.

FLOOD WAY