
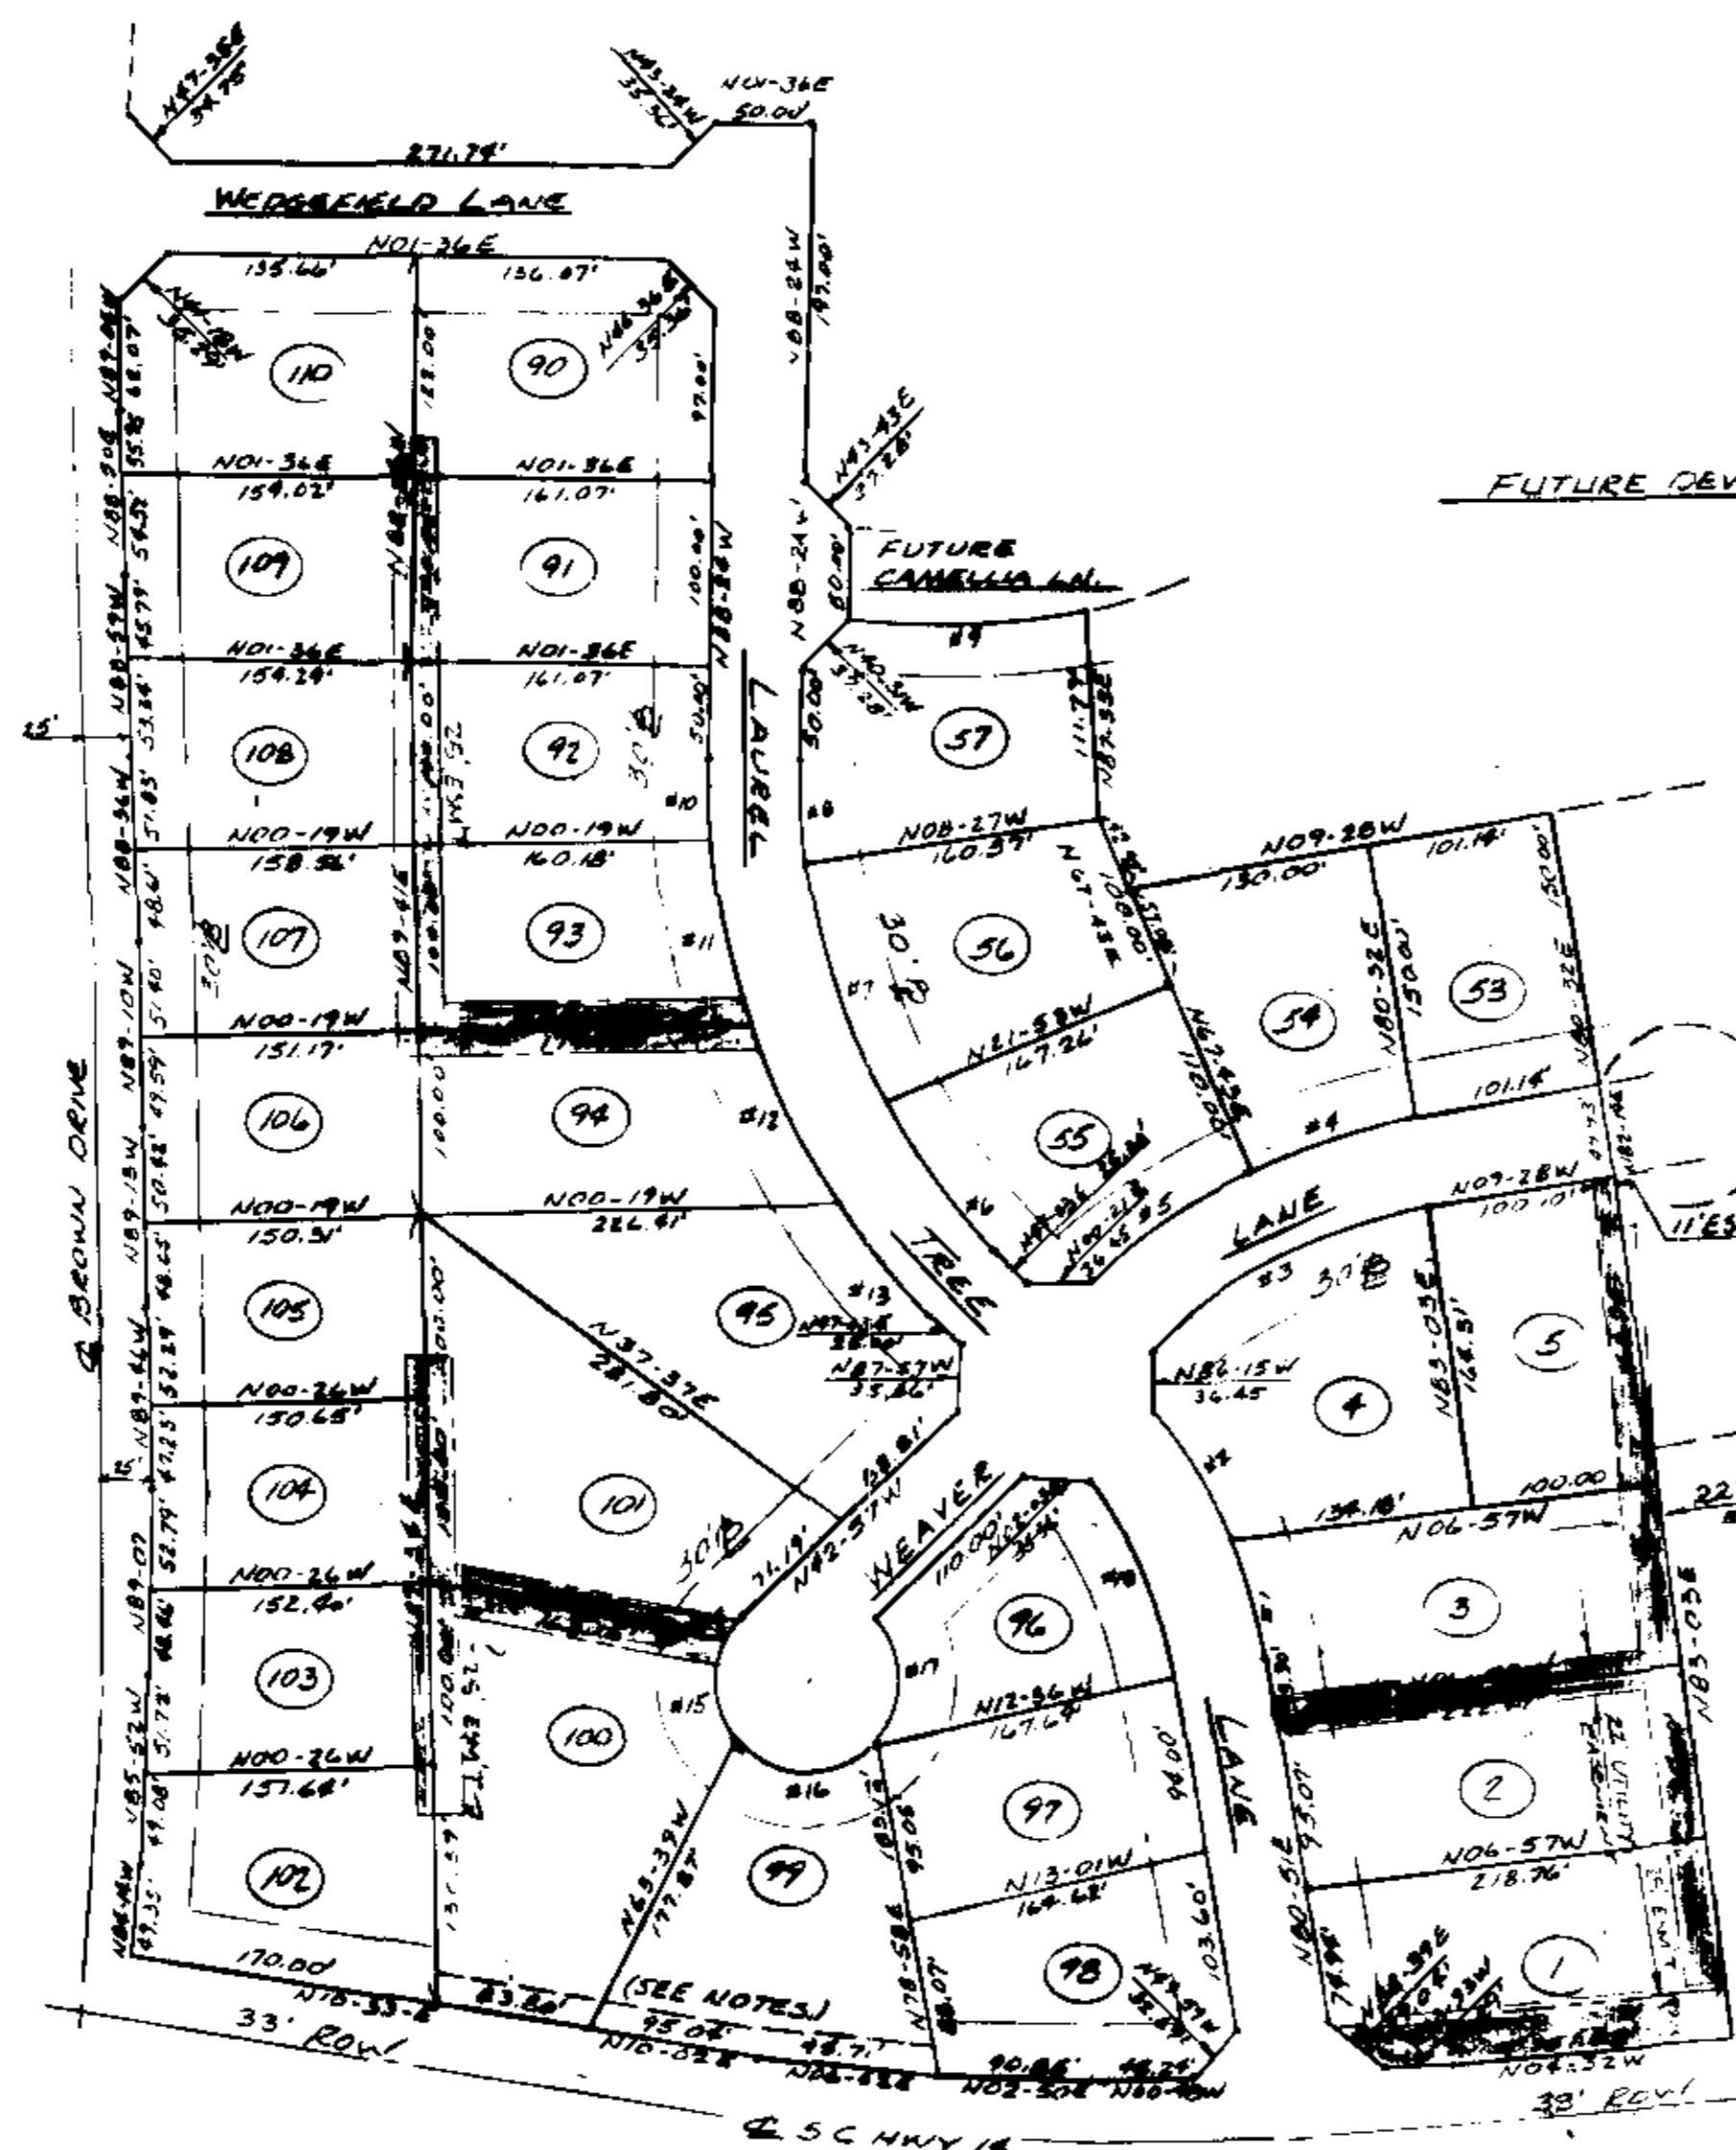


FILED
 APR 23 1 27 PM '82
 DDNN
 WILKINSON
 P.M.C.

CURVES					
NO.	CHORD BEARING	CHORD	ARC	RADIUS	DELTA
1.	N74-07-41E	67.54	67.69	288.25	13-27-29
2.	N60-08-03E	79.48	79.73	288.25	15-50-53
3.	N 26-11-44W	267.74	179.76	290.77	22-31-48
4.	N17-22-36W	93.83	94.13	340.77	15-49-34
5.	N34-07-45W	104.08	105.08	340.77	17-37-44
6.	N54-29-36E	97.82	98.09	377.48	14-53-22
7.	N72-26-47E	137.69	138.46	377.48	21-01-00
8.	N87-14-25E	57.06	57.11	377.48	08-40-08
9.	N01-20-57W	127.17	127.79	1057.04	06-35-40
10.	N88-33-56E	44.65	44.67	427.48	05-59-15
11.	N78-47-36E	101.84	102.08	427.48	13-40-54
12.	N64-31-39E	110.48	110.79	427.48	14-50-59
13.	N52-04-32E	74.92	75.01	427.48	10-03-14
14.	N52-12-14W	16.08	16.15	50.00	18-30-18
15.	N86-23-23E	53.22	56.12	50.00	64-18-28
16.	N05-38-32E	75.00	84.81	50.00	97-11-14
17.	N87-57-05W	70.71	78.54	50.00	90-00-00
18.	N67-12-31E	116.89	118.09	238.25	28-23-59

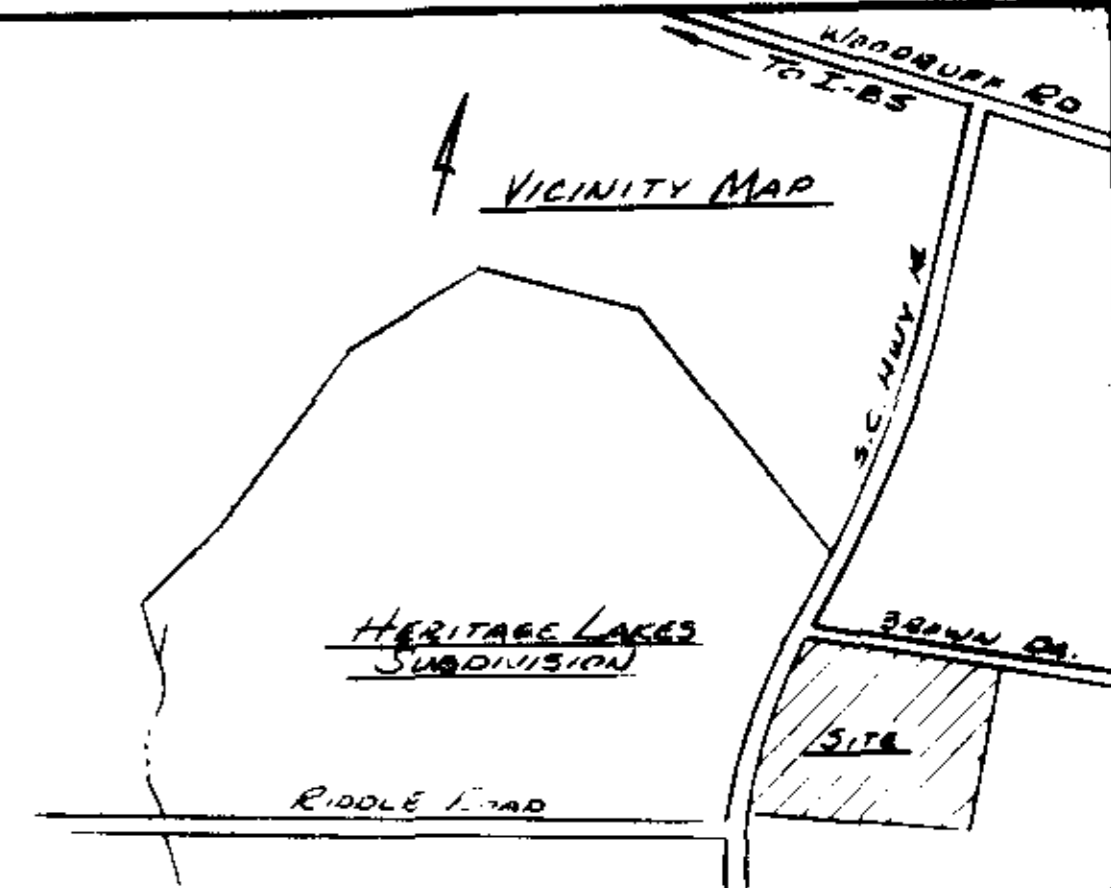

NOTE:

- ALL LOTS TO HAVE A 5' DRAINAGE & UTILITY EASEMENT ALONG SIDE LOT LINES AND A 10' EASEMENT ALONG REAR LOT LINES UNLESS OTHERWISE NOTED ON PLAT.
- ALL LOT CORNERS ARE MARKED WITH 1/2" IRON PINS.
- 15 FT STRIP ACROSS REAR OF LOTS 99 & 100 IS FOR BEAUTIFICATION ONLY. NO ACCESS TO HWY 14 IS ALLOWED ACROSS STRIP.

8-P-77

21125
REVISED
 4-29-82
 DATE

REVISION:
 1. CHA EASEMENT @ LOT 5 4-27-82

FINAL PLAT

CERTIFICATE OF OWNERSHIP AND DEDICATION

"The undersigned hereby acknowledge that I am (we are) the owner(s) of the property shown and described hereon and that I (we) hereby adopt this plan of subdivision with my (our) free consent and that I (we) establish the minimum building restriction lines, and hereby dedicate to public use as roads, streets, and easements, forever all areas so shown or indicated on said plat.

4, 28, 82 Signed Thomas C. Coft
 _____ Signed _____
 _____ Signed _____
 _____ Signed _____

CERTIFICATE OF ACCURACY

"I, RONALD E. BLACKMORE, certify that this plat was (was not) (drawn under my supervision) (an actual survey made under my supervision) from (was not) (was) (made by me) (done) (description recorded in Book _____ Page _____ Book _____ Page _____ etc.) (other) that the error of closure as calculated by latitudes and departures is 1:10,000 that the boundaries not surveyed are shown as broken lines plotted from information found in Book _____ Page _____ that this plat was prepared in accordance with the Greenville County Subdivision Regulations as adopted.

MAY 4, 1981 DATE Ronald E. Blackmore
 LICENSED ENGINEER OR REGISTERED SURVEYOR

S. C. Registration No. 5291

CERTIFICATE OF APPROVAL FOR RECORDING

"I hereby certify that the subdivision plat shown hereon has been found to comply with the Subdivision Regulations for Greenville County, with the exception of such variances, if any, as are noted in the minutes of the Greenville County Planning Commission of Greenville County, South Carolina, and that it has been approved for recording in the office of the County Register of Mense Conveyance."

4-29-82 DATE F. J. Fisher
 DIRECTOR OF PLANNING
 GREENVILLE COUNTY PLANNING COMMISSION

81-103
 FILE NUMBER


R-15

wedgfield subdivison
 SECTION I

THE FORTIS CORP. GREENVILLE, S.C. OWNER
 HEANER ENGR. CO. INC. GREENWOOD, S.C. SURVEYOR

NO. OF ACRES: 16.5 MILES 0.42

NO. OF LOTS: 31 DATE: MAY 4, 1981

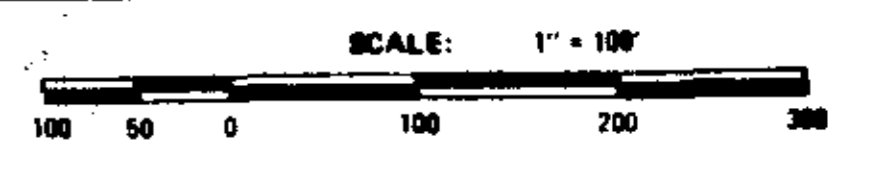

Plat Filed This 29 day of April 1982
 And Recorded in Vol. 8-P Page 77 at 1:27 P.M.
Donnie S. Sanders
 Register Mens Conveyance Greenville County, S. C.

5000'S
 6270
 1 APR 29 1982