


8429

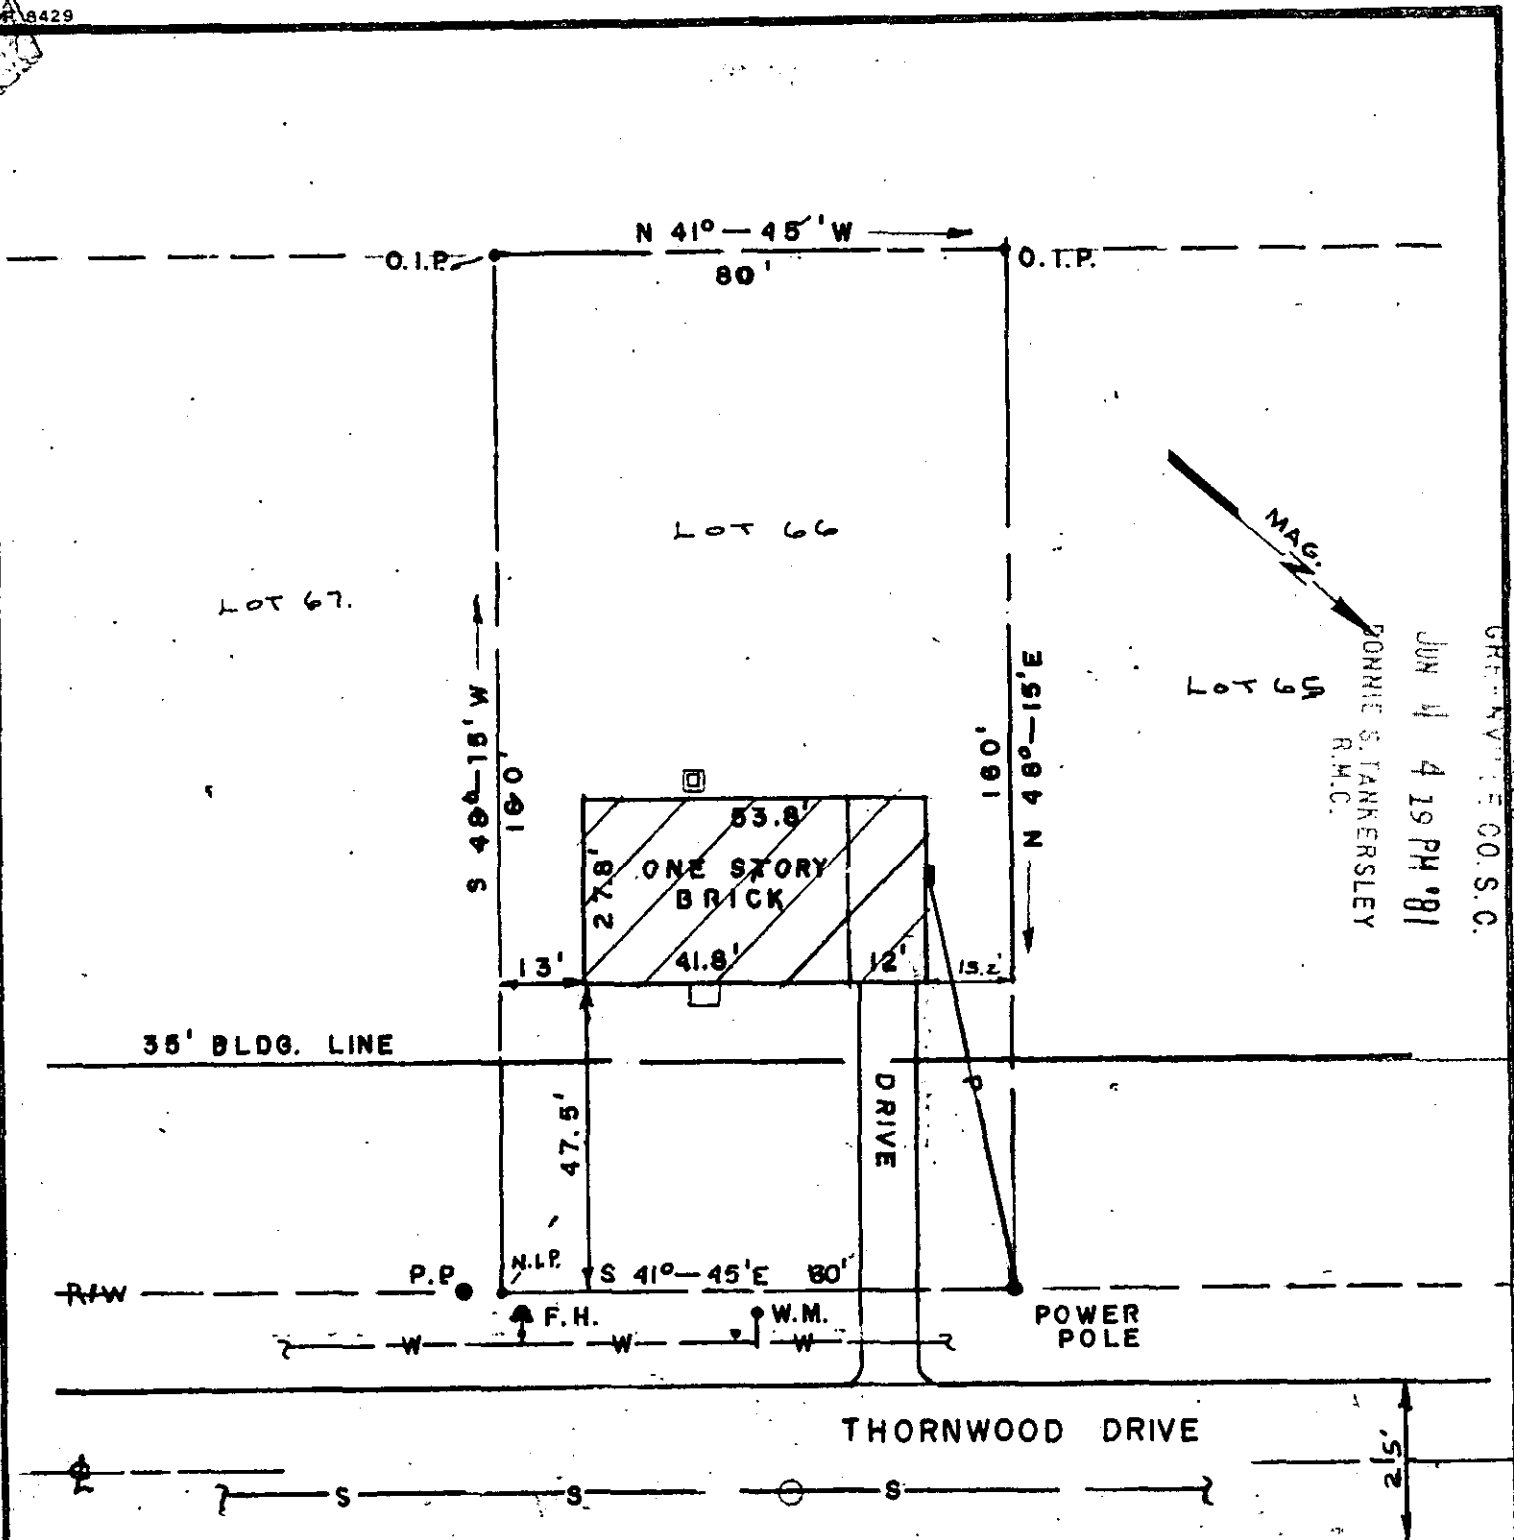

MAG.
 JUN 4 4 19 PM '81
 DONNIE S. TANKERSLEY
 R.M.C.
 9 10 6

FILED
 GREENVILLE CO. S.C.


8-R-29
 33834

This is to certify that the above property was surveyed as shown on this plat and that the property lines, walls and buildings are as shown hereon; that the buildings located on said lot do not encroach or project on adjacent streets or property; that no adjacent walls or buildings encroach or project on this lot.

PLAT BK. MM 105
 GREENVILLE CO.
 TAYLORS, S.C.

JUN 4 1981

Richard P. Gould
 S.C. REG. NO 4035

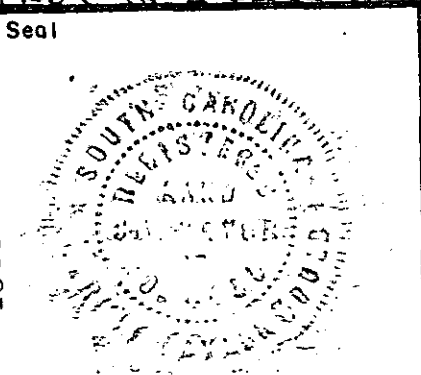

PROPERTY OF
 ZANE G. & ROBERTA B. STUBBS
 GOULD & ASSOC SURVEYORS
 TAYLORS, S.C.

Drawn By	K.T.G. JR.
Checked By	
Scale	1" = 30'
Date	6-1-81
File No.	
Dwg. No.	