


FILED
GREENVILLE CO. S.C.
JUN 8 3 00 PM '81
DONNIE S. TANKERSLEY
R.M.C.

BALLENGER CORP.

KATHLEEN C.
KILGORE

CONCRETE BEARING
5/28/81
N 19° 14' 36" E

H.C. HOWARD

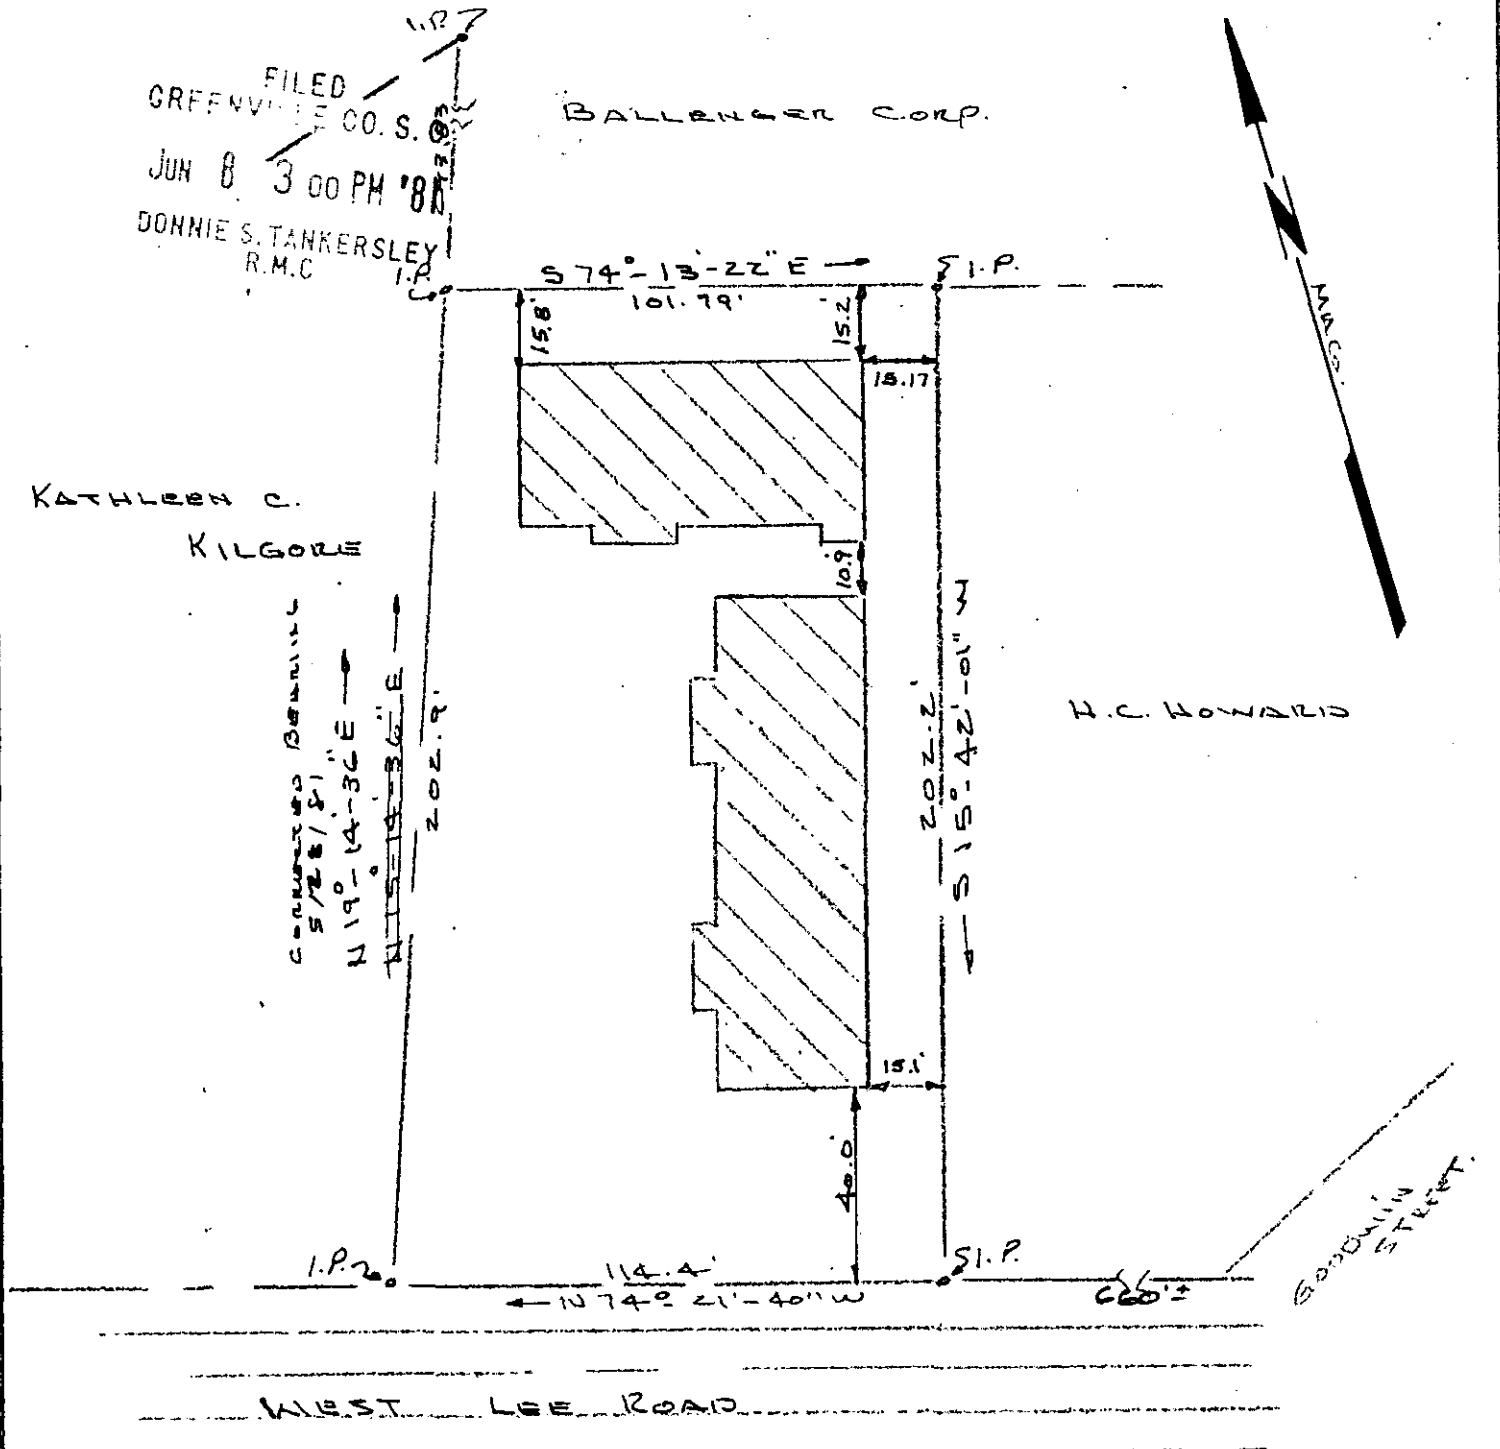

This is to certify that the above property was surveyed as shown on this plat and that the property lines, walls and buildings are as shown hereon; that the buildings located on said lot do not encroach or project on adjacent streets or property; that no adjacent walls or buildings encroach or project on this lot.

34099

JUN 8 1981

8-R-321

Kenneth J. Gould
S.C. REG. NO 4035

300 8 19221801

Seal 	PROPERTY	Drawn By K.T.G.
	OF	Checked By
	T.N.E. ASSOCIATES	Scale 1" = 40'
	GREENVILLE COUNTY GREENVILLE S.C.	Date 5-23-81
GOULD SURVEYORS TAYLORS, S.C.	FILE No.	Dwg. No.