


Note: Improvements on this lot are not in a flood hazard area.

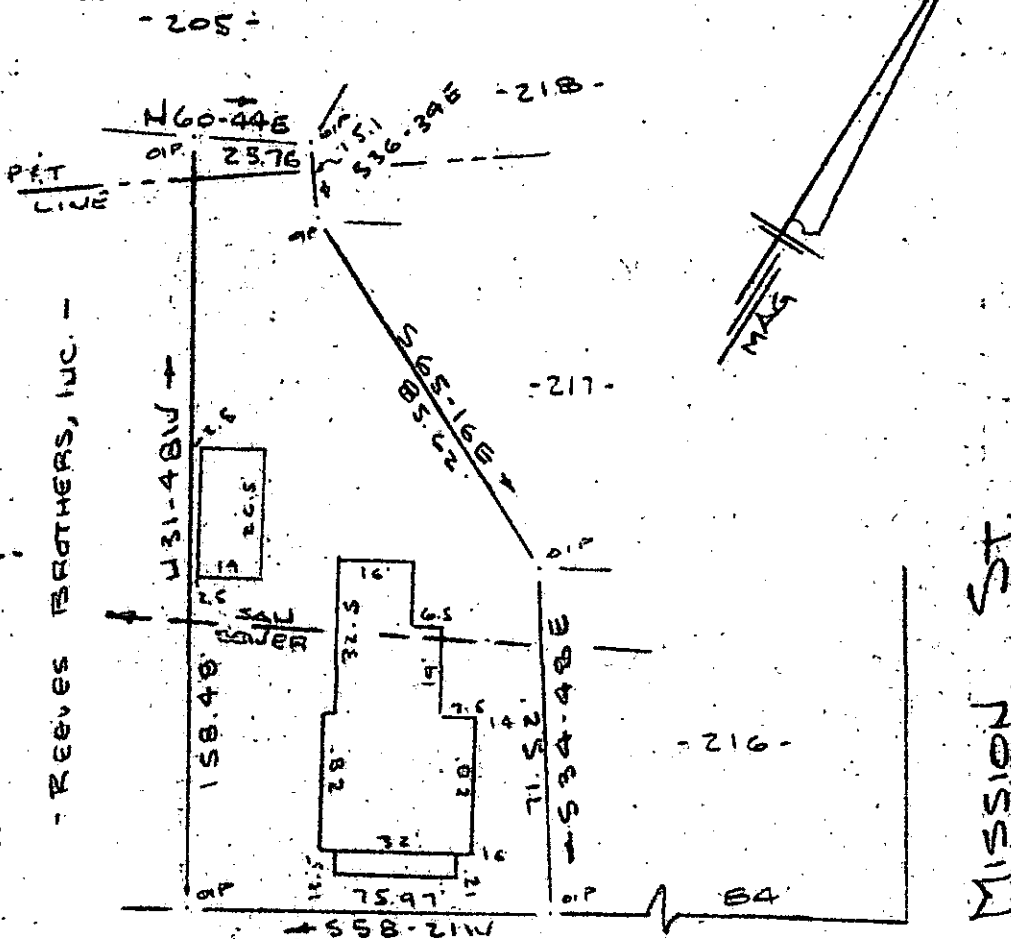

REEVES BROTHERS, INC.

N/A

MISSION ST

JUL 13 1981

FILED GREENVILLE CO. S.C.


JUL 13 12 59 PM '81

DONNIE S. TANKERSLEY R.M.C.

PARK STREET WATER & SEWER IN STRAY

PROPERTY OF PARK STREET ASSOCIATES, A GENERAL PARTNERSHIP GREENVILLE S.C.

SCALE 1"=40' 25 MARCH 1981

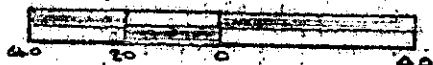

This is to certify that on the 25th day of March, 1981, I surveyed the property shown on this plat, being known as PROPERTY OF PARK STREET ASSOCIATES, A GENERAL PARTNERSHIP and recorded in the RMC Office Greenville County, S. C., in Plat Book at Page ; and that the property lines, walls and buildings are as shown hereon, and that the walls and buildings located on said lot do not encroach or project on adjacent street or property, and that no adjacent walls or buildings encroach or project on said premises, and no power lines cross this property except as shown hereon.

8-R-97 ✓ 1020

CAROLINA SURVEYING CO.  
 112 Main St.  
 Greenville, S. C.

R. B. Bruce  
 R. B. Bruce  
 AUTHENTICATED  
 170'S

300 8 24781801