


FILED
GREENVILLE CO. S.C.
JAN 28 4 20 PM '82
DONNIE S. TANKERSLEY
R.M.C.

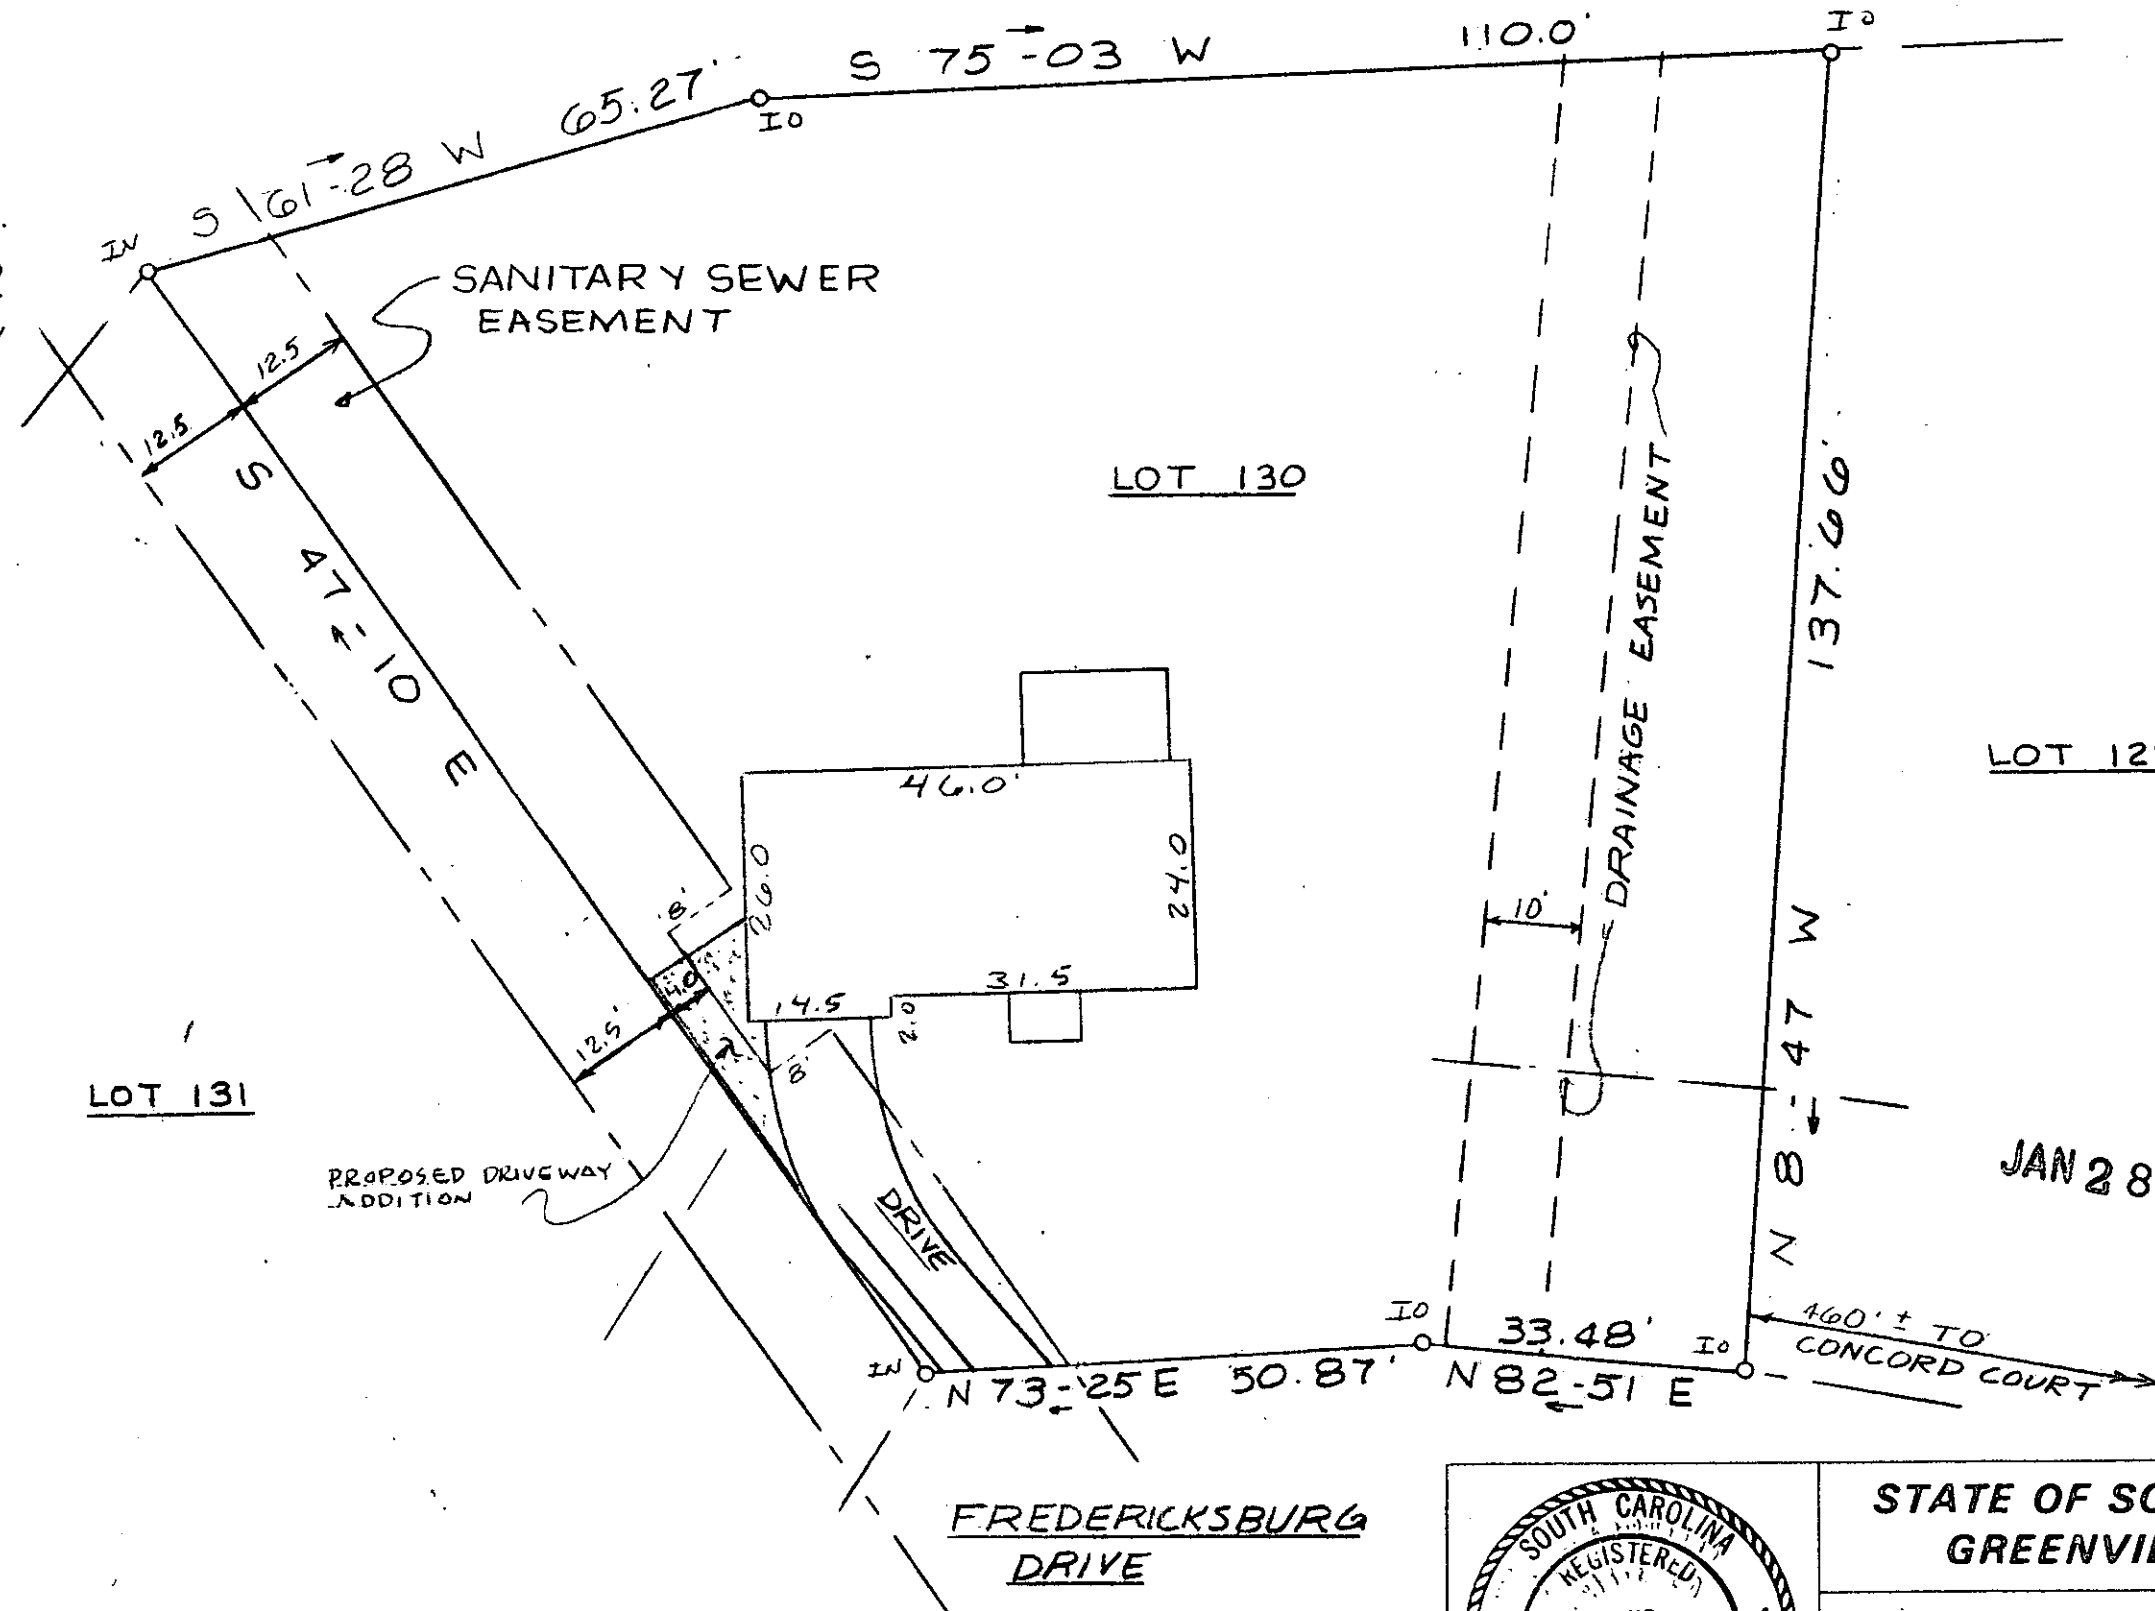

JAN 28 1982 8-V-75 ✓

LOT 131

LOT 130

LOT 129

FREDERICKSBURG
DRIVE



STATE OF SOUTH CAROLINA
GREENVILLE COUNTY

SEWER EASEMENT REVISION
LOT 130 - SEC 3
POWDERHORN

FREELAND & ASSOCIATES Engineers • Land Surveyors	
GREENVILLE, S.C.	
SURVEY	FL
DRAWN	KS
CHECK	MAC
SCALE	1" = 20'
DATE	11-10-81
DWG. NO.	7032

MICROFILMED