


MICROFILMED

HUBERT STREET

WEST POINSETT STREET  
WATER & SEWER (14 FT R/W)

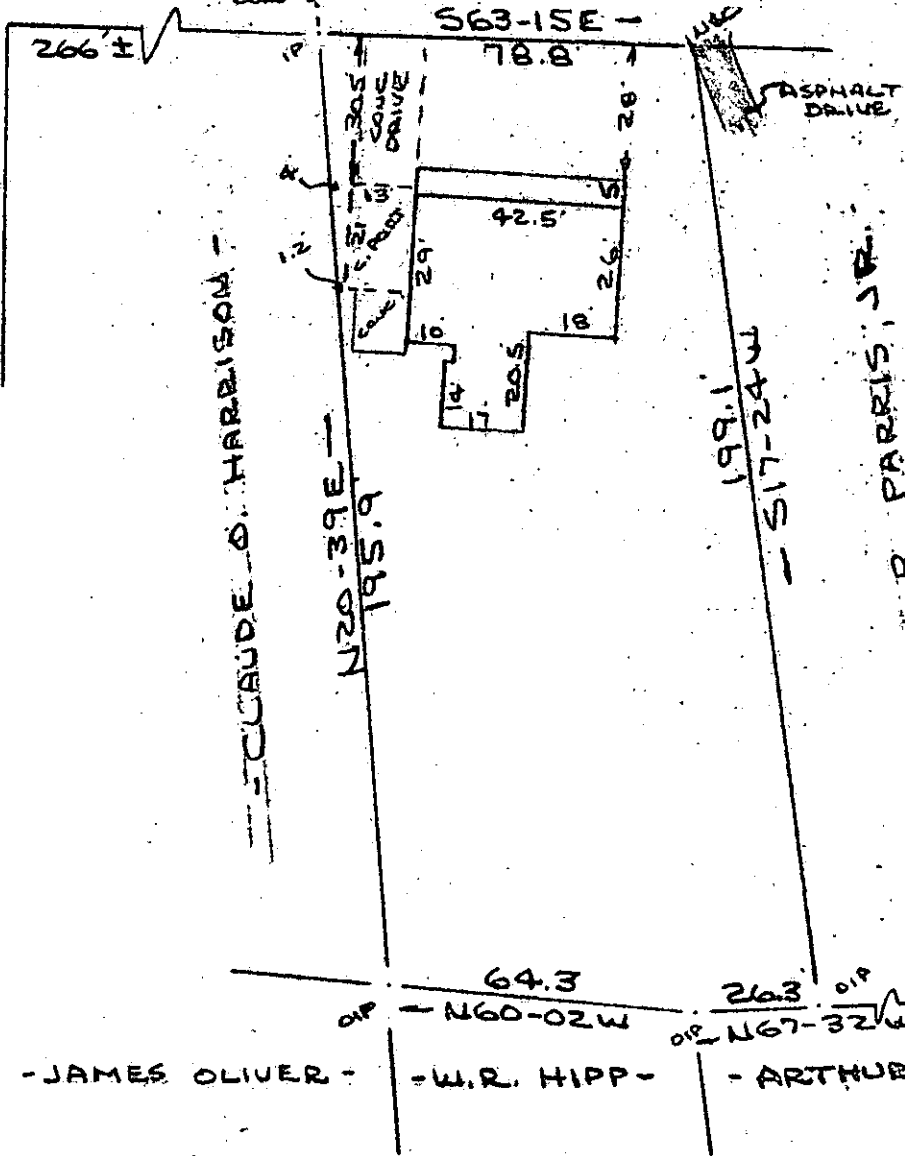


Notes:  
Improvements  
on this lot are  
not in a flood  
hazard area.

FILED  
GREENVILLE CO. S.C.  
OCT 20 2 31 PM '81  
DONNIE S. TANKERSLEY  
R.M.C.

64.3  
OF - N60-02W  
- JAMES OLIVER -  
263 01P  
OF - N67-32W  
- W.R. HIPPI -  
36 01P  
- ARTHUR STERLINS -

PROPERTY OF  
PAUL D. LISTER & PAULA J. LAWRENCE  
GREENVILLE COUNTY, GREENVILLE, S.C.  
SCALE: 1" = 40' 14 OCT 1981

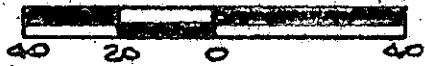

This is to certify that on the 14th day of October, 1981, I surveyed the property shown on this plat, being known as PROPERTY OF PAUL D. LISTER & PAULA J. LAWRENCE and recorded in the REC Office Greenville County, S. C., in Plat Book at Page ; and that the property lines, walls and buildings are as shown hereon, and that the walls and buildings located on said lot do not encroach or project on adjacent street or property, and that no adjacent walls or buildings encroach or project on said premises, and no power lines cross this property except as shown hereon.

8-W-17 ✓

9954

R. B. Bruce  
R. B. Bruce, RLS #1952

OCT 20 1981

CAROLINA SURVEYING CO.  
112 TO - Manly 2 0620.81 1427 3.00CI  
Greenville, S. C.

23A/4A

G23-A-4