

PROPERTY OF
SHARON Y. LITTLE
 GREENVILLE, SOUTH CAROLINA
 NOV. 25, 1981 SCALE: 1" = 30'

13002


8-W-81

This is to certify that on November 25, 1981, I surveyed the property shown on this plat, known as Lot No. 24 of Queen Heights, as shown on a plat recorded in the RMC Office for Greenville County, in Plat Book G, Page 87, and that the property lines, walls and building are as shown hereon, and that no walls or buildings project nor encroach on adjacent streets or property, and that no adjacent walls or buildings project nor encroach on said lot, and that no utility lines cross this lot except as may be shown, and the degree of accuracy is 1/4,000.

NOTE: This property is not located within a flood hazard area.

Survey by: Richard D. Wooten, Jr.
 Greenville, South Carolina

NOV 30 1981

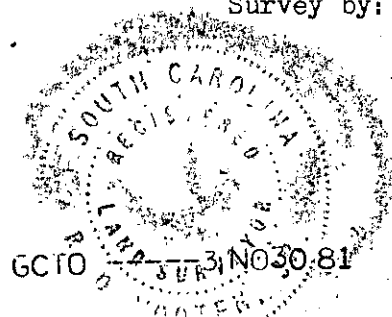

Richard D. Wooten, Jr.
 S. C. R. L. S.No. 4678