

This is to certify that on December 30, 1981, I surveyed the property shown on this plat, known as Lot 1 on plat of property of W.R. & Essie L. Lewis, recorded in the RMC Office of Greenville County in Plat Book FF on page 410, and that the property lines, walls and buildings are as shown hereon; that the building located on said lot does not encroach or project on adjacent streets or property, and that no adjacent walls or buildings encroach or project on said premises, and that no utility lines cross this property except as shown hereon. This property is not located in a designated flood hazard area.


*James R. Freeland*  
James R. Freeland RLS & PE 4781

DEC 31 1981

FILED  
GREENVILLE CO. S.C.  
DEC 31 2 46 PM '81  
DONNIE S. TANKERSLEY  
R.M.C.

8-X-34

15248

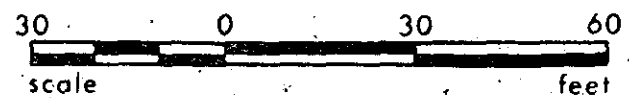

1838.5' ± TO  
EASLEY BRIDGE RD.

240.2-1-14



**STATE OF SOUTH CAROLINA  
GREENVILLE COUNTY**

W.R. & ESSIE L. LEWIS PROPERTY

LOT - 1  
PROPERTY OF  
JAMES D. GIRARDEAU  
BILLIE K. GIRARDEAU

FREELAND & ASSOCIATES  
Engineers • Land Surveyors

GREENVILLE, S.C.

SURVEY JC
DRAWN KS
CHECK <i>WBA</i>
SCALE 1" = 30'
DATE 12-30-81
DWG. NO. 7129 3.00CD

PRINT MACHINE INC.