


MICROFILMED

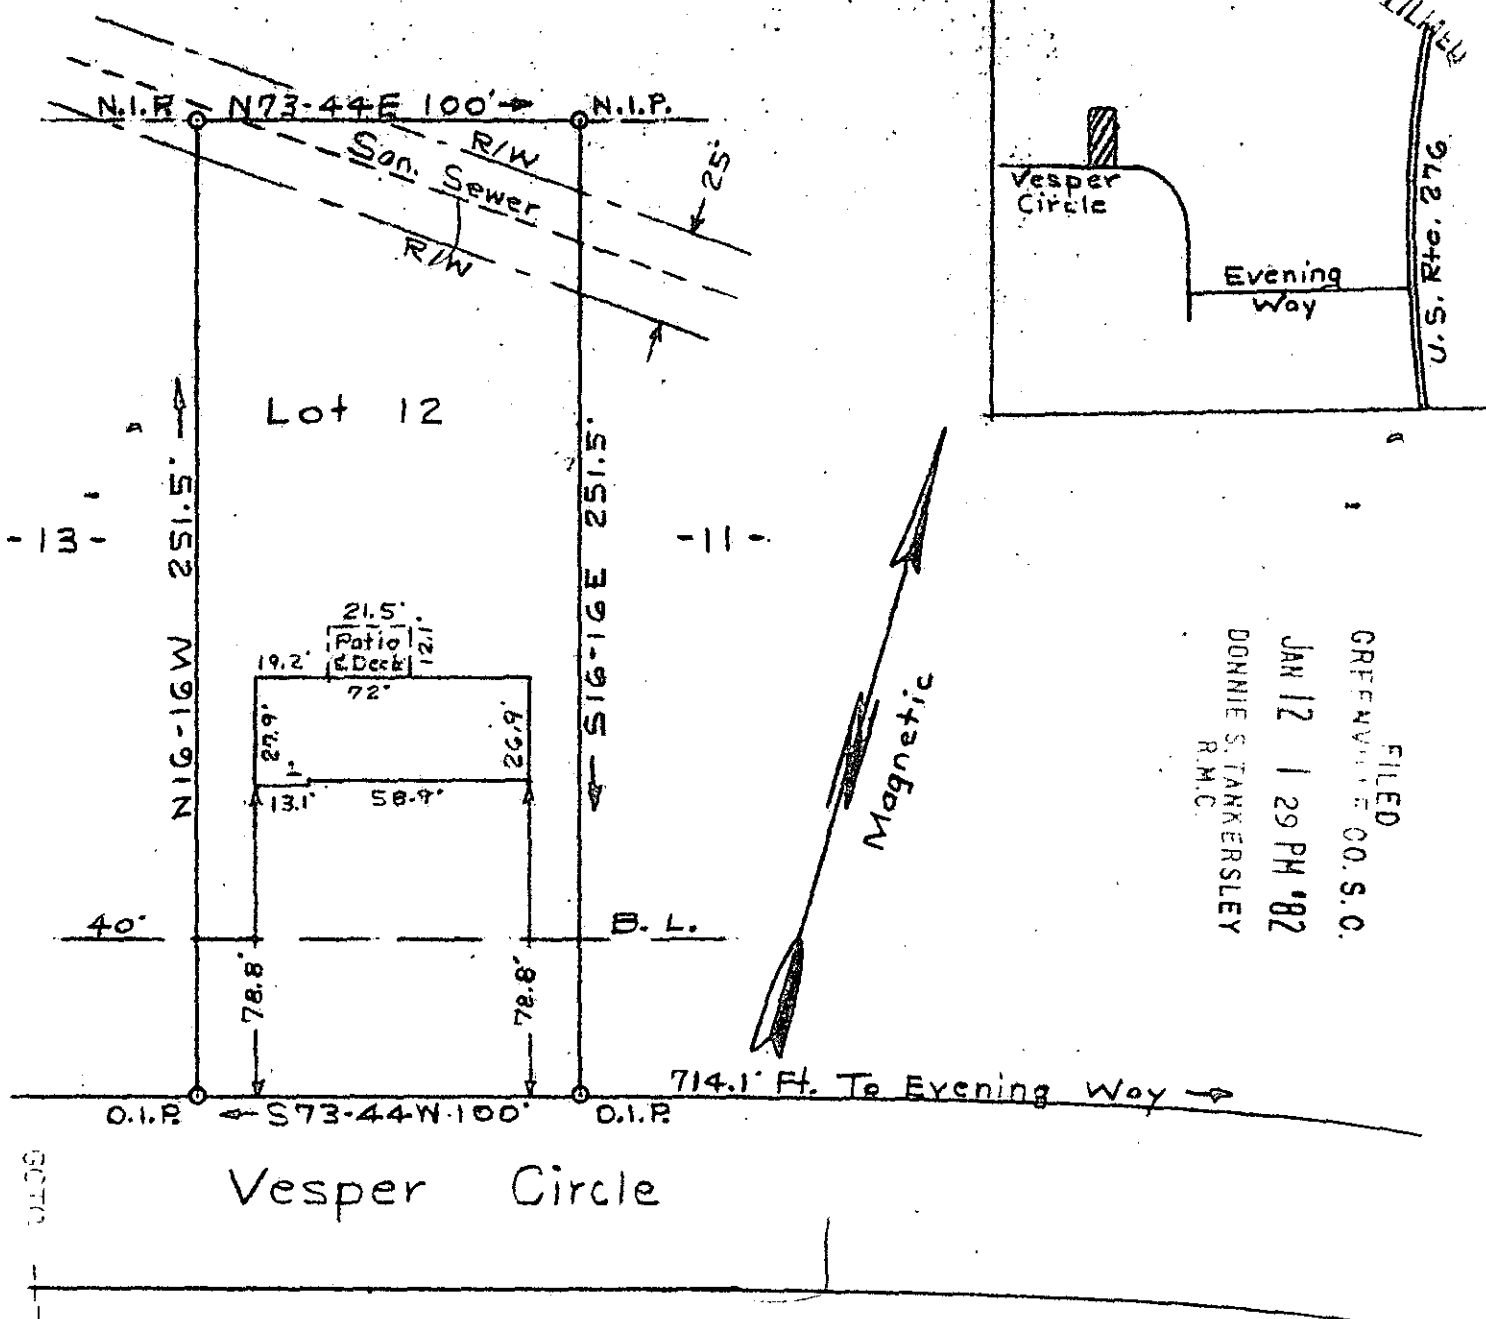

FILED
 GREENVILLE CO. S.C.
 JAN 12 1 29 PM '82
 DONNIE S. TANKERSLEY
 R.M.C.

PROPERTY OF
 CURTIS O. & ALEDA M. MOORE
 15970 GREENVILLE CO. MAULDIN, S. C.

Scale 1" = 50' Dec. 28, 1981
 T. H. Walker Jr. Reg. L. S. 3182
 300 Maple Dr. Mauldin, S. C.

50 0 50 100

Error of closure exceeds 1/2500



SCTD 1 JAN 12 82 121 3.0001

8-X-46
 JAN 12 1982

Ref. Plat of "Sunset Heights" Sec. 2, Pl. Bk. RR - Pg. 85 T. H. Walker Jr.