

FILED
 GREENVILLE CO. S.C.
 MAR 17 12 26 PM '82
 DONALD J. LAWRENCE
 A.M.C.


20772

8-2-11

MAR 17 1982

This is to certify that on March 9, 1982, I surveyed the property shown on this plat, known as Property of David Buckner Jr., recorded in the RMC Office of Greenville County in Plat Book 5-0 on page 31, and that the property lines, walls and buildings are as shown hereon; that the building located on said lot does not encroach or project on adjacent streets or property, and that no adjacent walls or buildings encroach or project on said premises, and that no utility lines cross this property except as shown hereon. This property is not located in a designated flood hazard area.

James R. Freeland
 James R. Freeland RLS & PE 4781

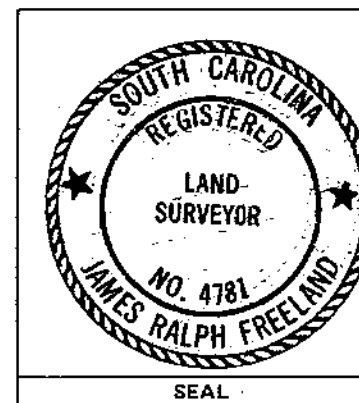

STATE OF SOUTH CAROLINA
 GREENVILLE COUNTY

FREELAND & ASSOCIATES
 Engineers • Land Surveyors
 GREENVILLE, S.C.

PROPERTY OF
 D. R. HUDSON

| |
|------------------|
| SURVEY D.W. |
| DRAWN B.P. |
| CHECK MLC |
| SCALE 1" = 100' |
| DATE MARCH 9, 82 |
| DWG. NO. 7286 |



5.0001