
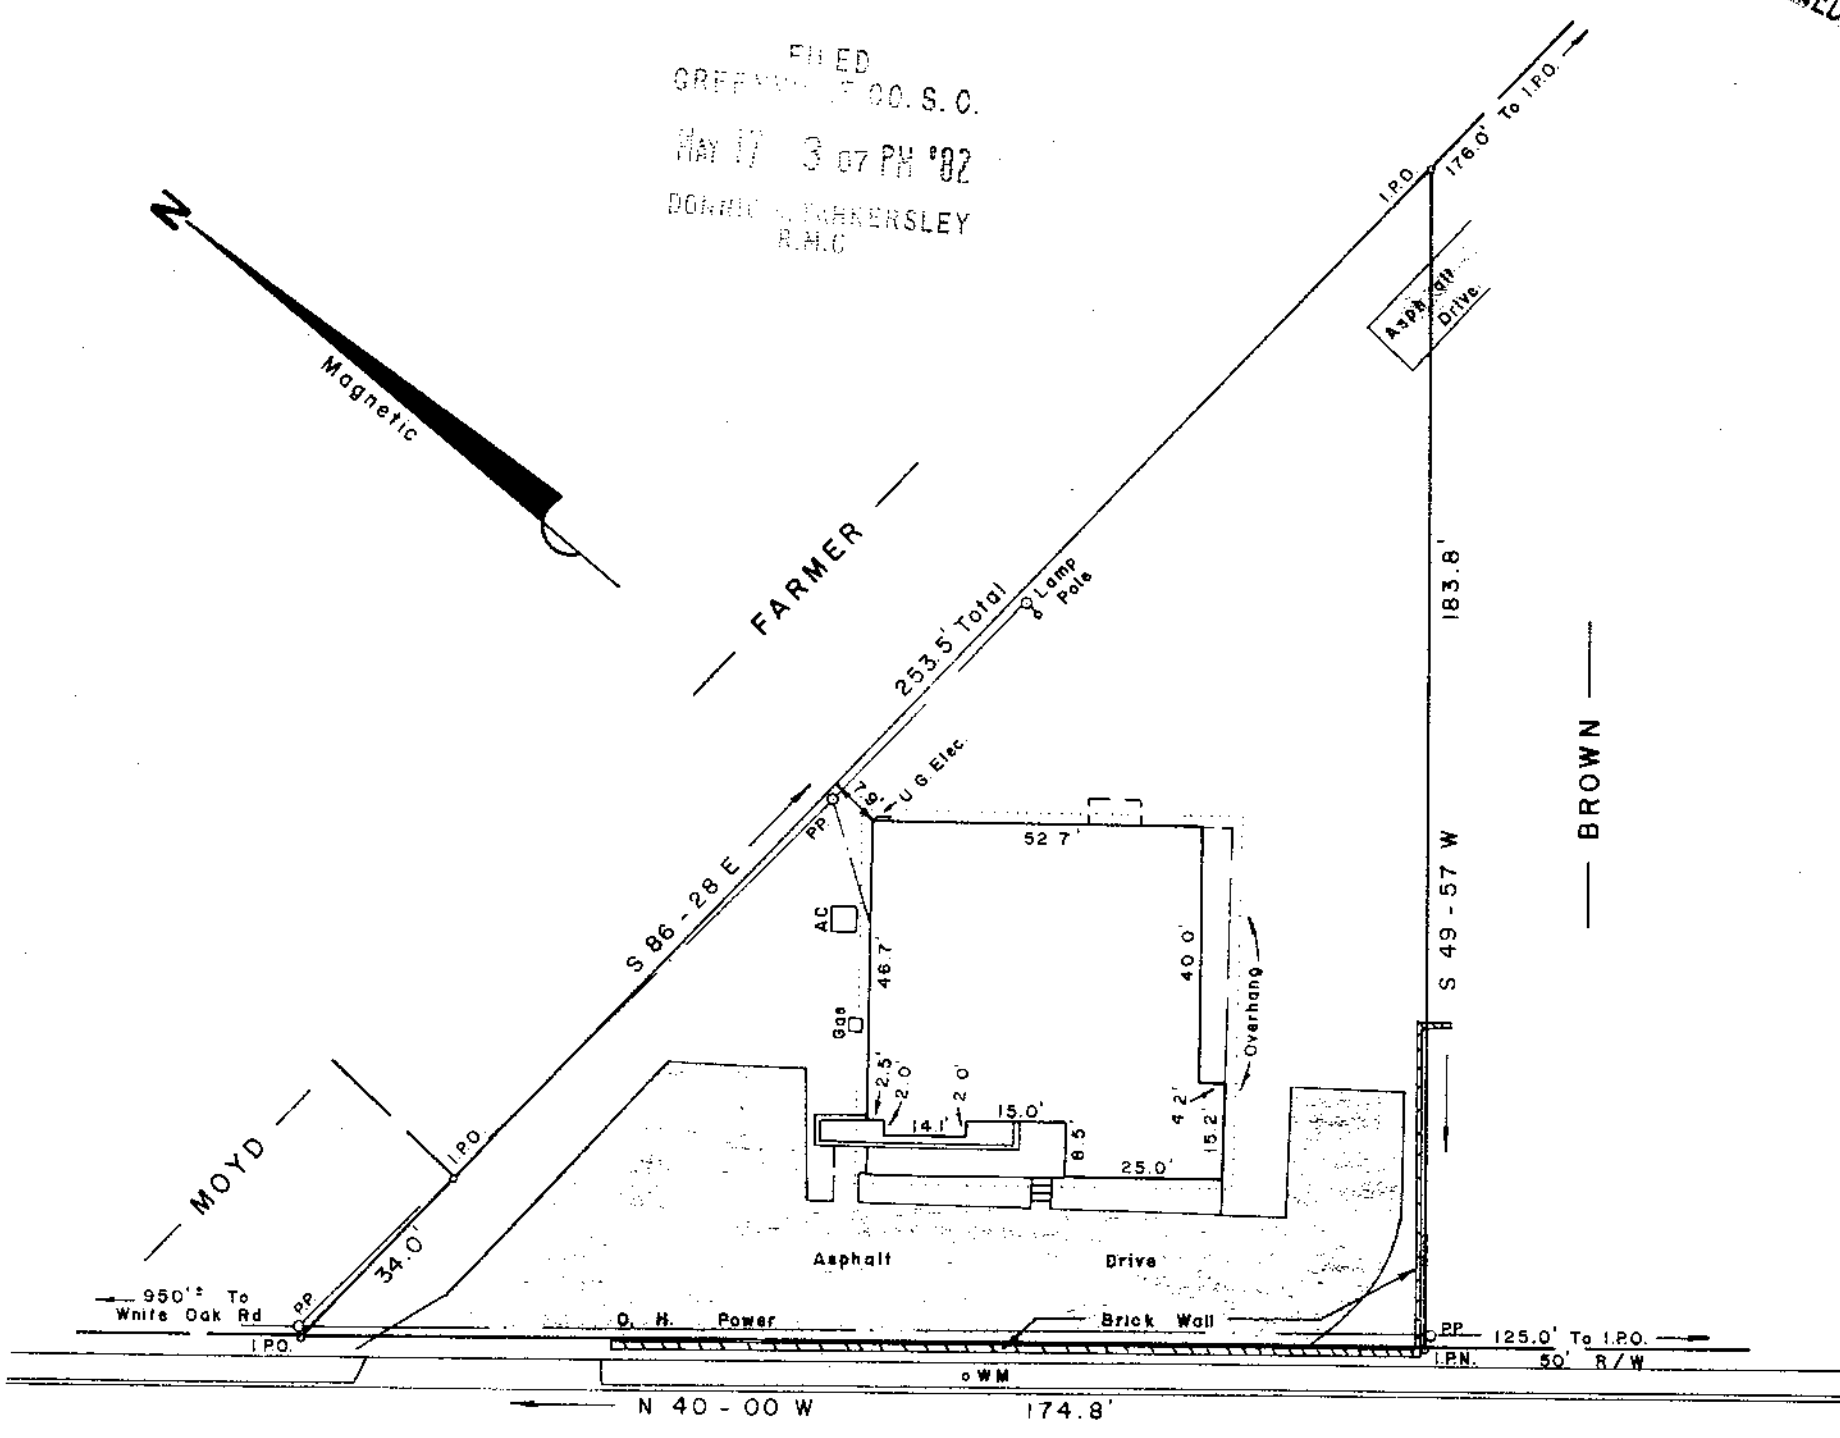


MICROFILMED

FILED
GREENVILLE CO. S. C.
MAY 17 3 07 PM '82
DOWNS & BARKERSLEY
R.M.C.

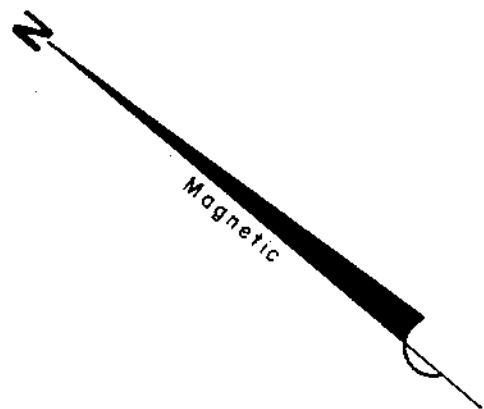

S. C. HIGHWAY No. 291

16,057 Sq. Ft.


SURVEY FOR WHITE AND MURRAY, CPA,s

MAY 17 1982 ✓ NEAR GREENVILLE GREENVILLE CO.
SOUTH CAROLINA
8-2-59 25550 MAY 12, 1982


This Lot Is Located In Flood Zone "C"
Area Of Minimal Flooding.

I Herby Certify That The Measurements As
Shown Above Are Correct And There Are No
Encroachments Or Projections Other Than
Shown.


I Herby Certify That The Ratio Of Precision
Of The Field Survey Is 1/5000 As
Shown Hereon And The Area Was Determined
By D. M. D. Method.


JEFFERY M. PLUMBLEE
INC.
REGISTERED LAND SURVEYOR
7881

P. O. BOX 788
TRAVELERS REST, S. C. 29690 (803) 834-4426

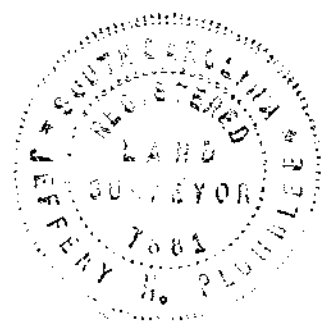

Jeffery M. Plumblee

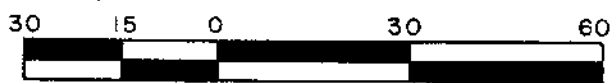

Scale 1" = 30'
275-1-61 2 MY17 82 938 5,000 CI