


MAG. NORTH S.C.  
GREENVILLE  
JUL 16 2 22 PM '86  
DONNIE S. TANKERSLEY  
R.M.C.

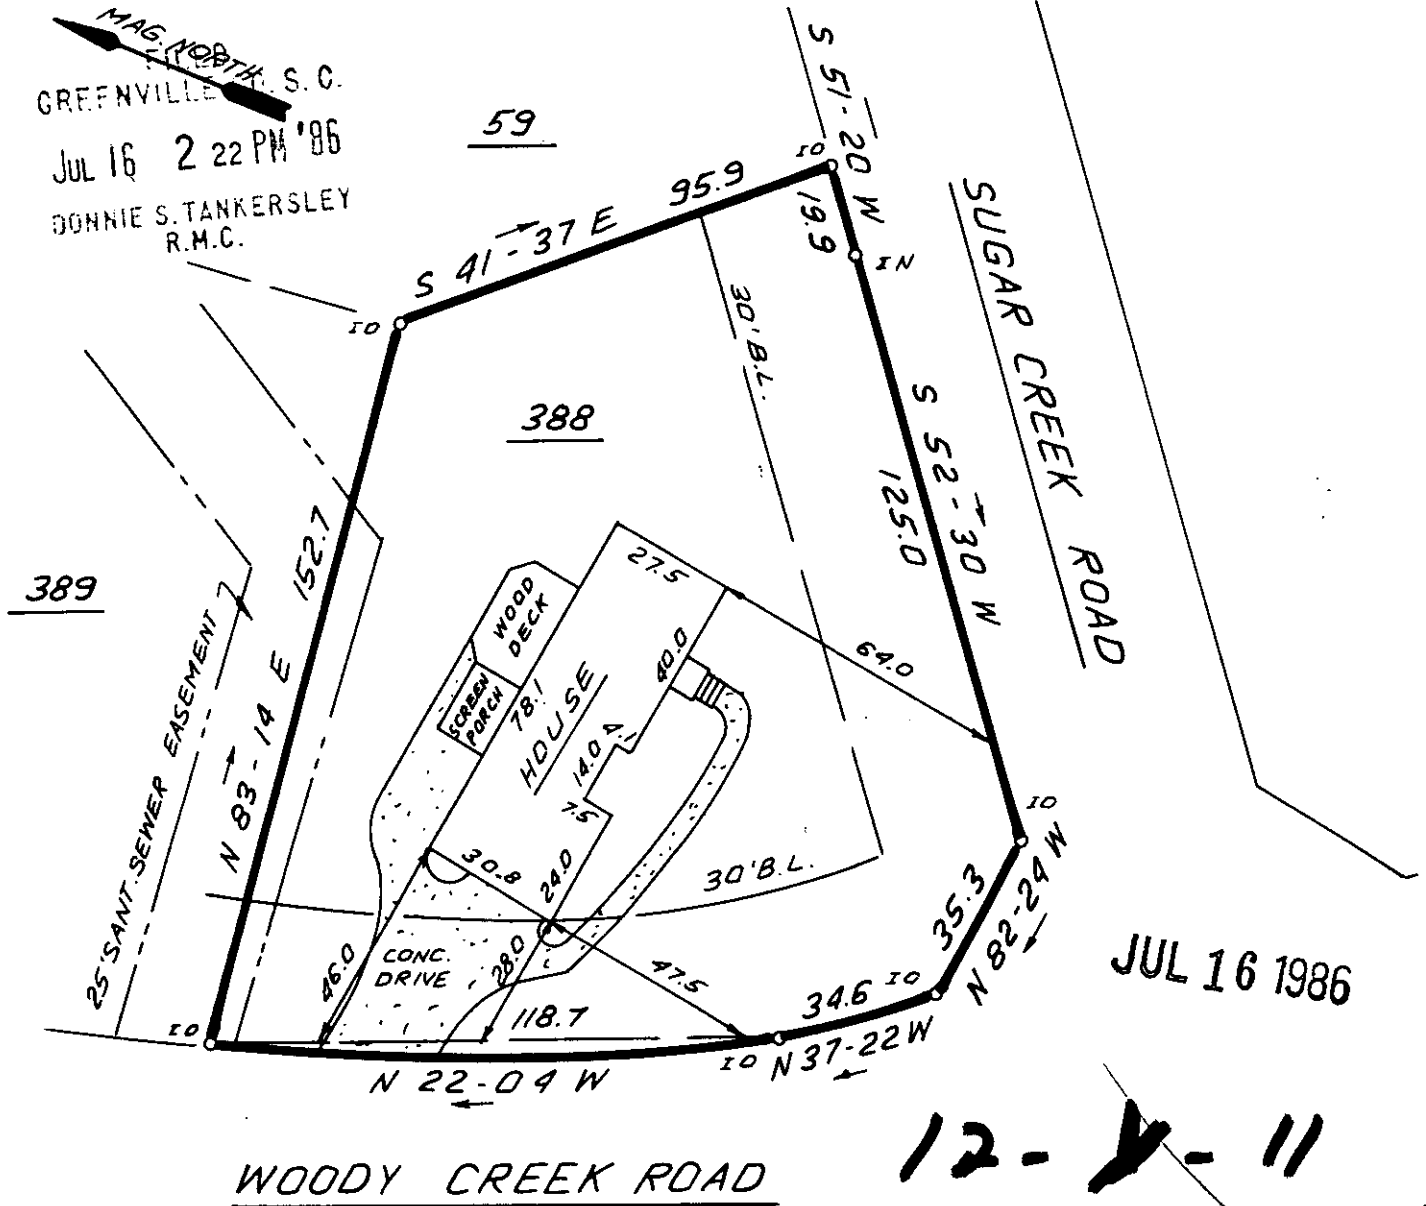

JUL 16 1986


12-4-11

2332



NOTE:  
5' DRAINAGE & UTILITY EASEMENT ALONG EACH  
SIDE OF ALL SIDE & REAR LOT LINES.

THIS IS TO CERTIFY THAT THE PROPERTY SHOWN ON THIS PLAT WAS SURVEYED UNDER MY DIRECT SUPERVISION  
PROPERTY LINES AND IMPROVEMENTS SHOWN ARE LOCATED CORRECTLY AND THAT NO VISIBLE ENCROACHMENTS  
EXIST UNLESS OTHERWISE SHOWN. THIS PROPERTY IS NOT LOCATED IN A DESIGNATED FLOOD HAZARD AREA

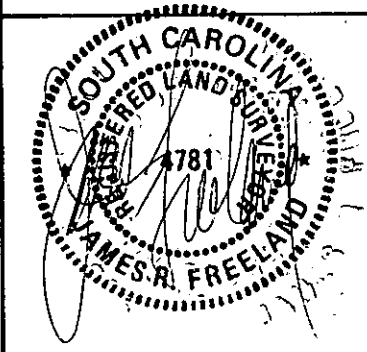

STATE OF SOUTH CAROLINA  
GREENVILLE COUNTY

SUGAR CREEK  
SEC. 2, MAP 1, LOT 388  
PROPERTY OF  
JAIME P. VILLANUEVA  
JOAN. M. VILLANUEVA

FREELAND-CLINKSCALES  
& ASSOCIATES, INC.  
Engineers • Land Surveyors  
323 WEST STONE AVENUE  
GREENVILLE, S.C.  
(803) 271-4924

|             |                  |
|-------------|------------------|
| PLAT BOOK   | 7C - 68          |
| DEED BOOK   | 1129 - 495       |
| TAX MAP     | 534.05 - 1 - 110 |
| PARTY CHIEF | J.P.S.           |
| DRAWN       | I.R.             |
| DATE        | JULY - 11 - 86   |
| DWG. NO.    | 15760            |

RLS JAMES R. FREELAND  
NO. 4781