




MRS. C. B. GRIFFITH N/F

141

142

143

144

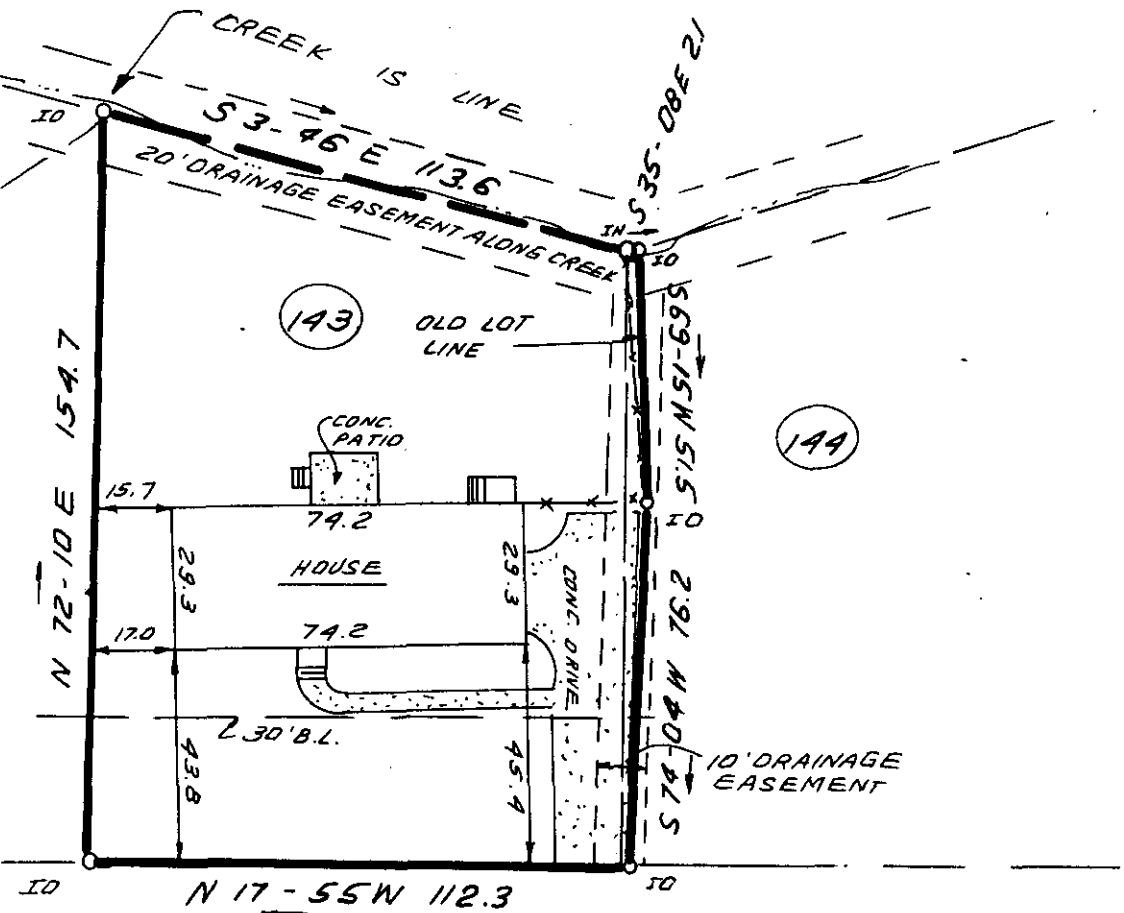

FILED
 GREENVILLE CO. S.C.
 JUL 17 12 19 PM '86
 DONNIE STANKERSLEY
 R.M.C.

LIBBY LANE

2490

JUL 17 1986

12-y-26



THIS IS TO CERTIFY THAT THE PROPERTY SHOWN ON THIS PLAT WAS SURVEYED UNDER MY DIRECT SUPERVISION PROPERTY LINES AND IMPROVEMENTS SHOWN ARE LOCATED CORRECTLY AND THAT NO VISIBLE ENCROACHMENTS EXIST UNLESS OTHERWISE SHOWN. THIS PROPERTY IS LOCATED IN A DESIGNATED FLOOD HAZARD AREA.

630
 2 JUL 17 86

	STATE OF SOUTH CAROLINA GREENVILLE COUNTY		FREELAND-CLINKSCALES & ASSOCIATES, INC. Engineers • Land Surveyors 323 WEST STONE AVENUE GREENVILLE, S.C. (803) 271-4924
	HILLSBOROUGH SEC. 3, LOT 143 PROPERTY OF REBECCA H. ANTLEY ✓ MARION D. VAUGHN ✓		PLAT BOOK 9N-42 DEED BOOK 118B-45 TAX MAP M4.5-1-142 PARTY CHIEF JEC DRAWN BR DATE 7-10-86 DWG. NO. 15743
RLS NCV JAMES R. FREELAND 4781			