MICROFILMED

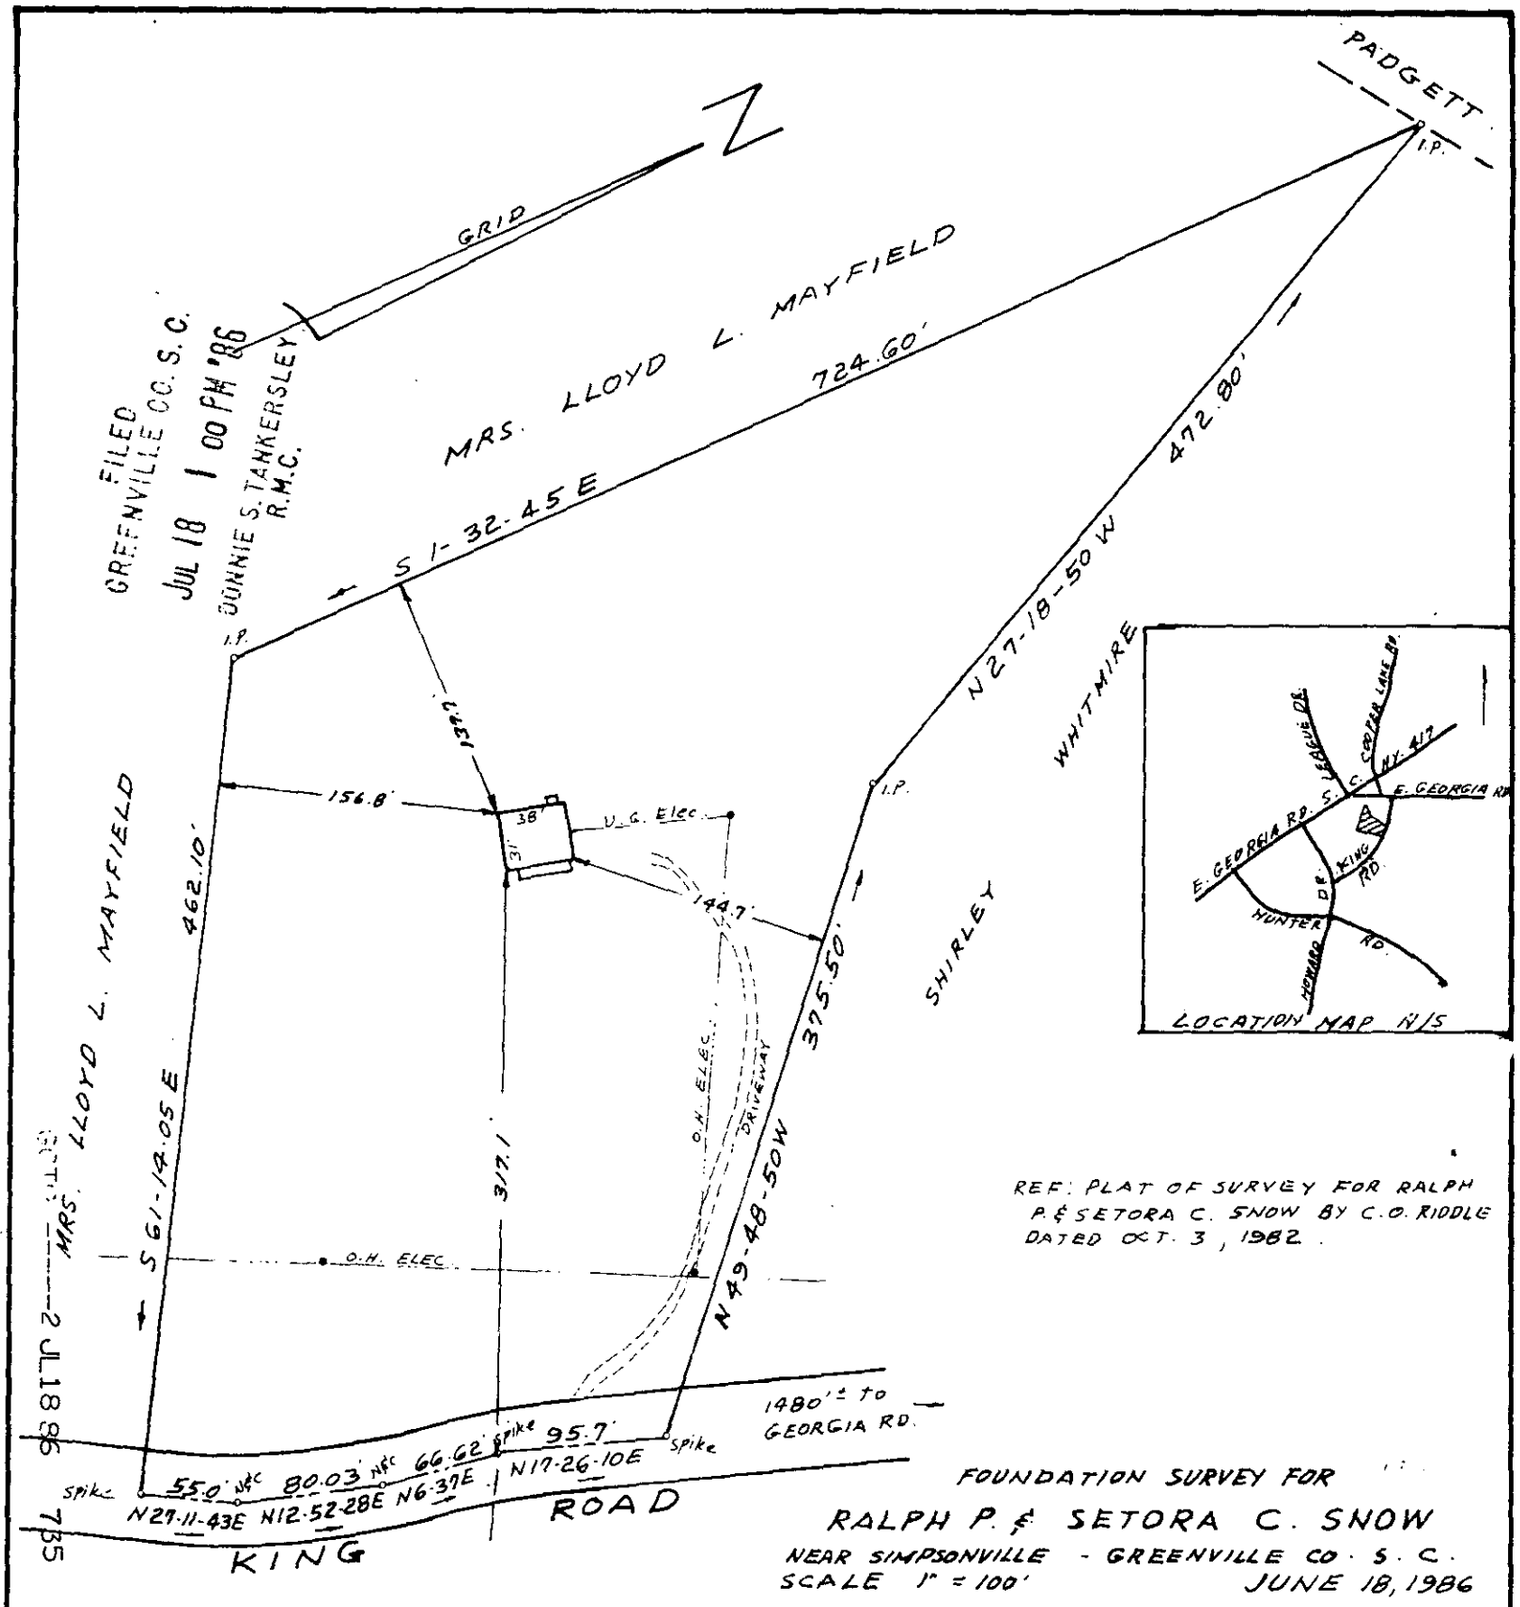

REF: PLAT OF SURVEY FOR RALPH P. & SETORA C. SNOW BY C.O. RIDDLE DATED OCT. 3, 1982.

FOUNDATION SURVEY FOR

RALPH P. & SETORA C. SNOW

NEAR SIMPSONVILLE - GREENVILLE CO. S.C.

SCALE 1" = 100' JUNE 18, 1986

I certify that this is an accurate plat of a survey made by me June 18th., 1986, that the structure located on said premises does not encroach or project on adjacent streets or property, that no easements are visible on the ground except as noted hereon, and that the structure located on said premises is not in a designated 100 year flood plain.

FILED
GREENVILLE CO. S.C.
JUL 18 1 00 PM '86
DONNIE S. TANKERSLEY
R.M.C.

2742

12-4-34

C. O. Riddle

RLS #1347 Greenville S.C.

2 JUL 18 86
735
00001