


FILED
GREENVILLE CO. S. C.
JUL 23 12 17 PM '86
DONNIE S. TANKERSLEY
R.M.C.

WALNUT ST.

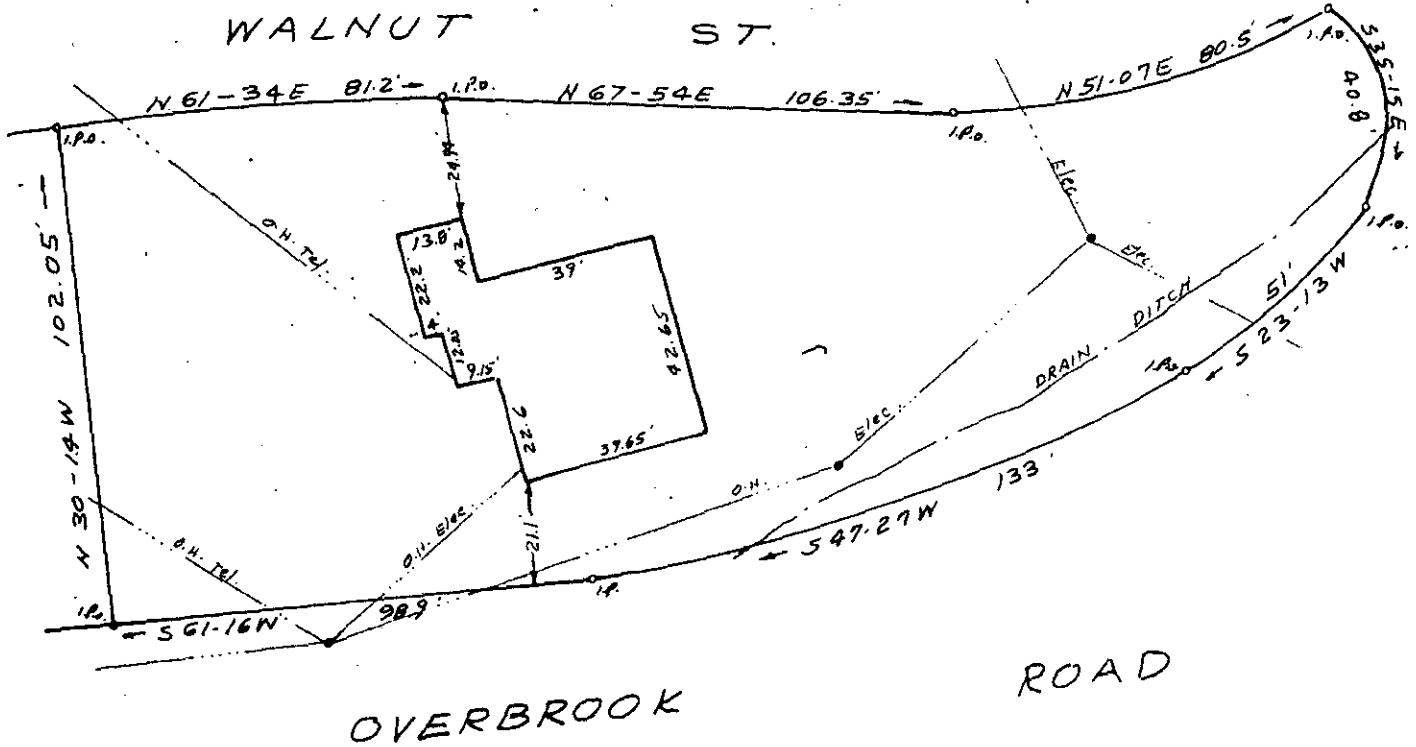

OVERBROOK ROAD

REF: PORTION LOT 159 ON PLAT #A3
OF OVERBROOK LAND CO. RECORDED IN
PLAT BOOK F PAGE 218.

3325

PROPERTY OF
PATRICK BRADLEY MORRAH III
AND
LINDA J. MORRAH
GREENVILLE S. C.

JUL 23 1986

12-4-73

SCALE 1" = 40'

JULY 25, 1980

I certify that this is an accurate plat of a survey made by me July 25th, 1980, that the improvements located on said premises do not encroach or project on adjacent streets or property, that no easements are visible on the ground except as shown hereon, and that the structures located on said premises are not in a designated flood plain based on the public records of Greenville County.

C.O. Riddle

R.L.S. # 1347 Greenville, S.C. 29606 1541

3.0001