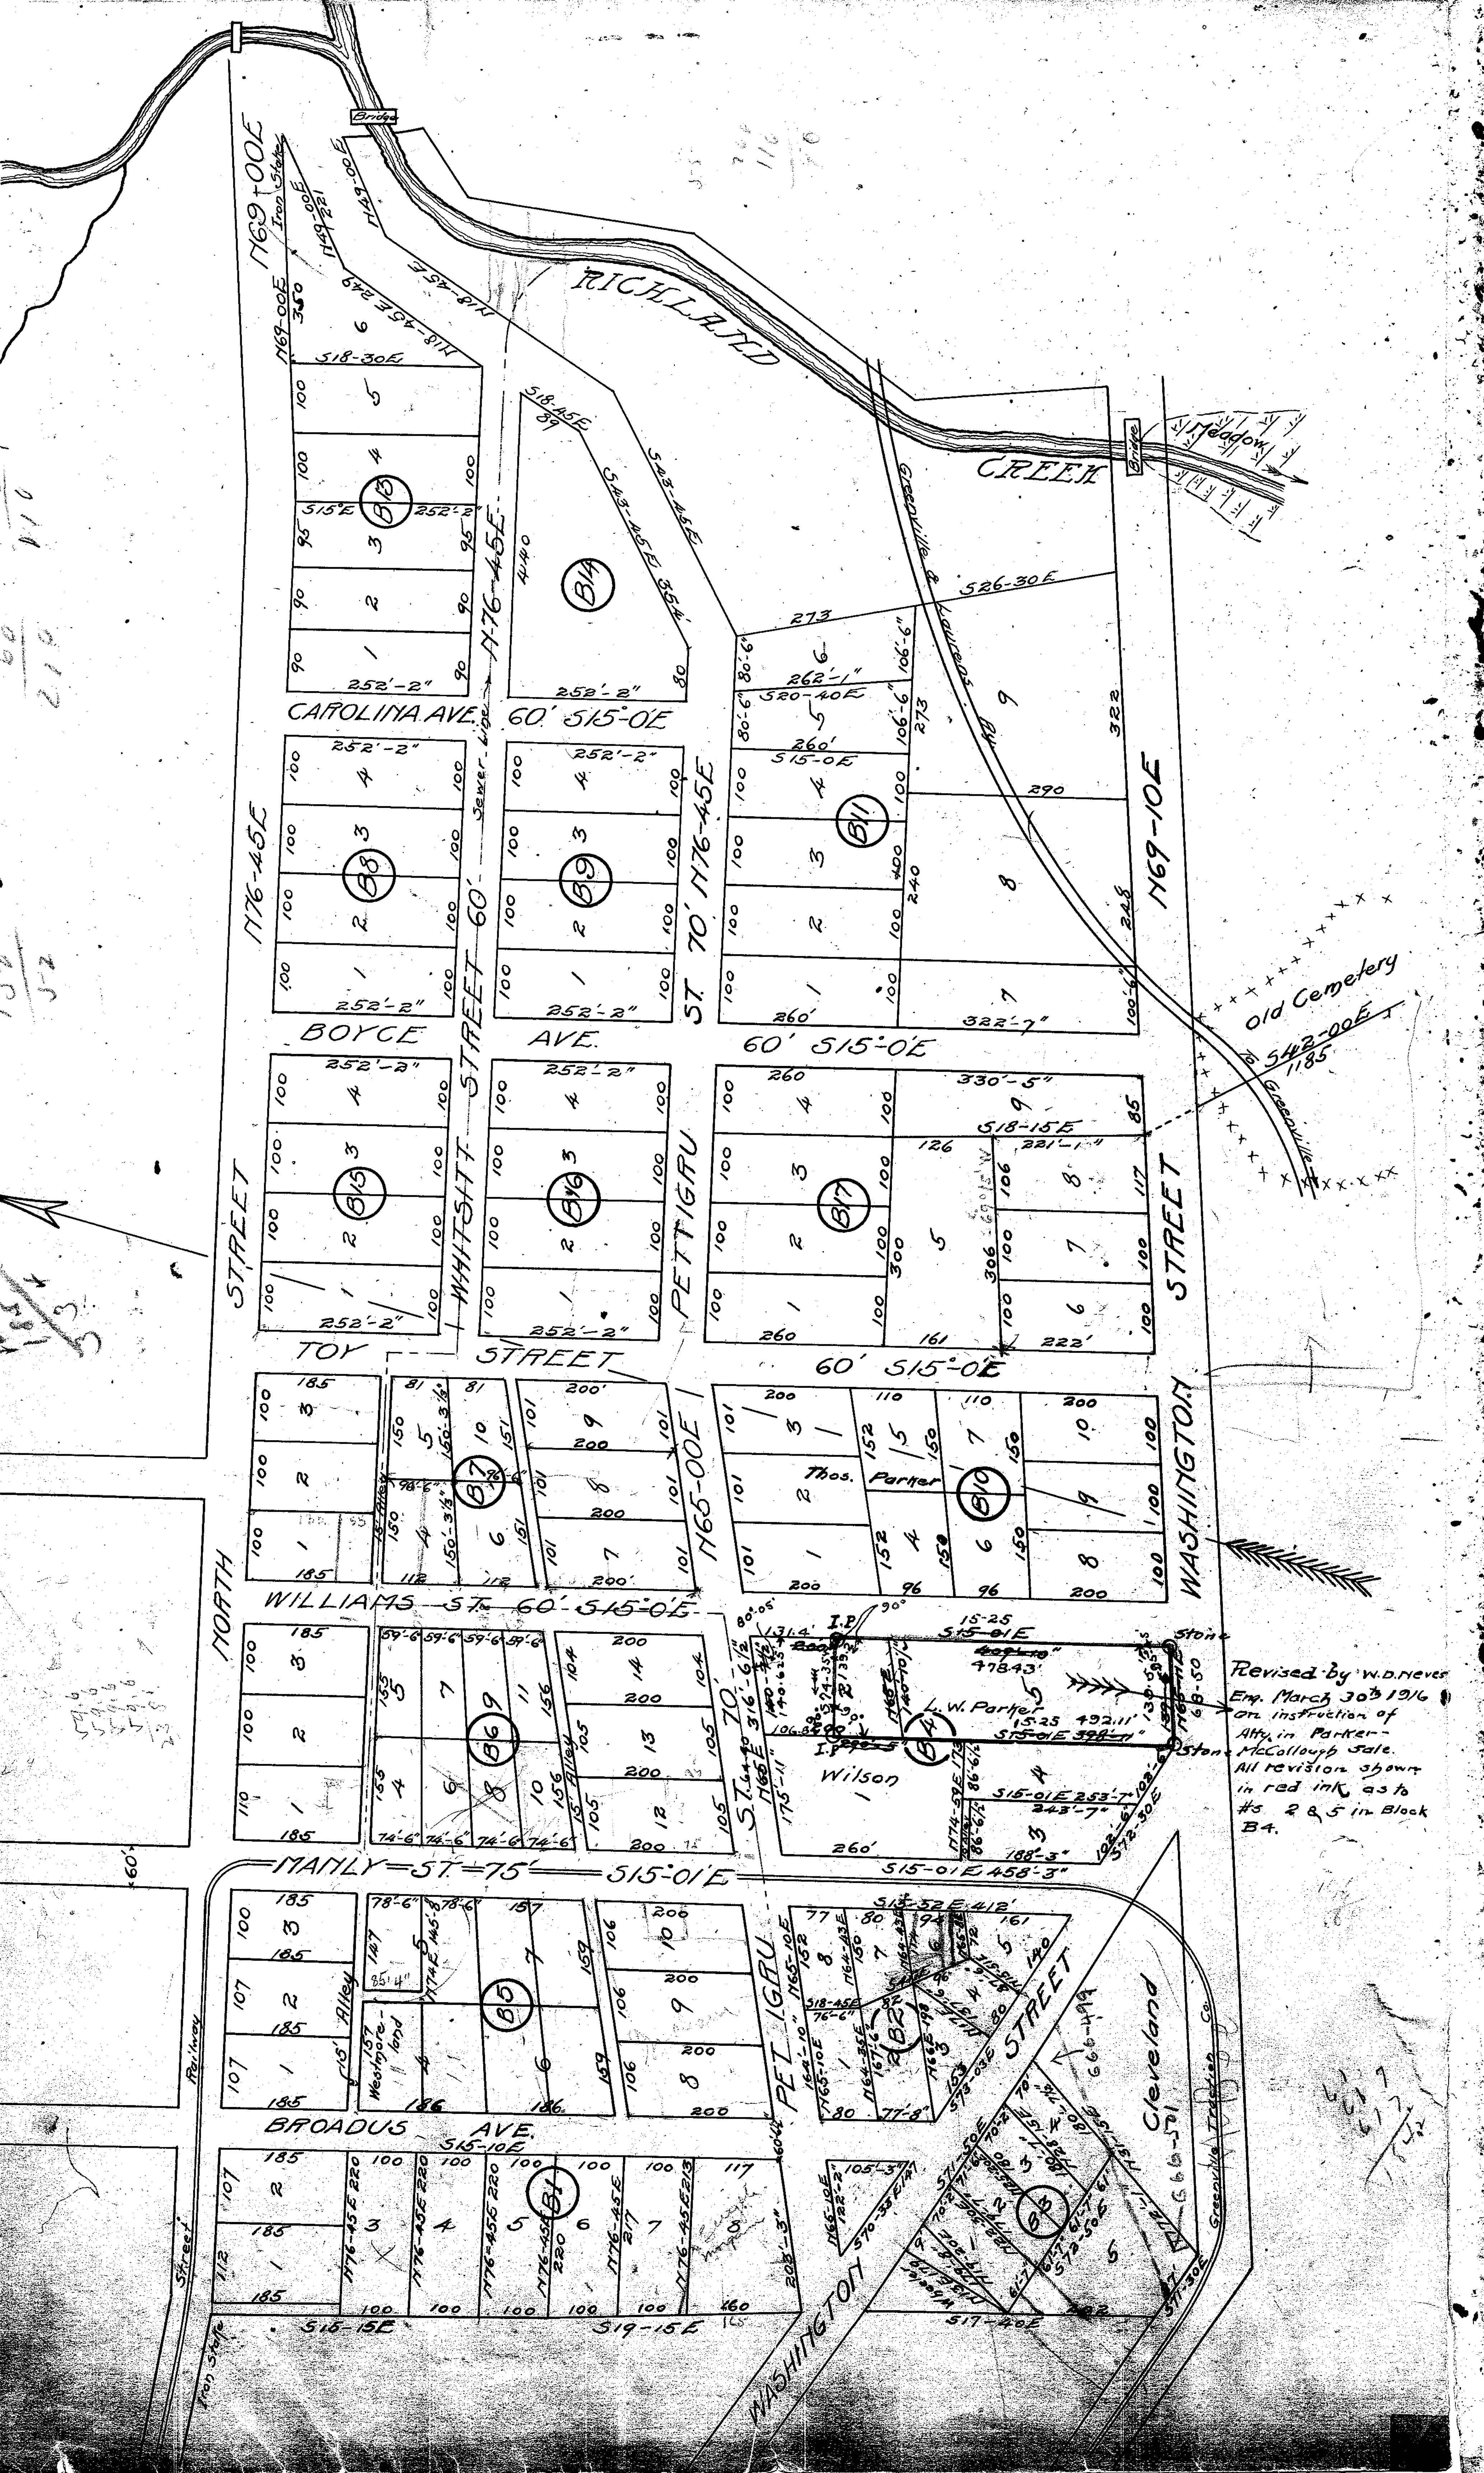

Bridge
RICHLAND
CREEK
Bridge
Meadow
Iron Stake
N69-00E
N49-00E
N18-45E
S18-30E
S18-45E
S43-45E
S26-30E
B13
B14
B8
B9
B11
B15
B16
B17
B7
B10
B6
B4
B5
B2
B1
B3
CAROLINA AVE. 60' S15-0E
Sewer Line
BOYCE AVE. 60' S15-0E
TOY STREET 60' S15-0E
WILLIAMS ST. 60' S15-0E
MANLY ST. 75' S15-01E
BROADUS AVE. S15-10E
NORTH STREET N76-45E
WHITSITT STREET 60' N76-45E
PETTIGRU ST. 70' N76-45E
PETTIGRU N65-00E
WASHINGTON STREET N69-10E
WASHINGTON
STREET
Greenville & Laurens Rd
Old Cemetery
S42-00E 1185
To Greenville
Thos. Parker
L. W. Parker
Wilson
I.P.
Stone
15' Alley
Alley
Westmoreland
Railway Street
Iron Stake
Cleveland
Greenville Traction Co.
S15-01E 458'-3"
S15-32E 412'
S17-40E
S15-15E
S19-15E
Revised by W.D. Neves Eng. March 30th 1916 on instruction of Atty. in Parker-McCollough Sale. All revision shown in red ink as to #5 2 & 5 in Block B4.