

Property of 2nd Presbyterian Church

Rhett Street

Mrs. A.C. Ferguson's Property

Wardlaw Street


S 18° 30' E

MARION STREET

C. & G. R.R.



N 18° 30' W

Crook Street

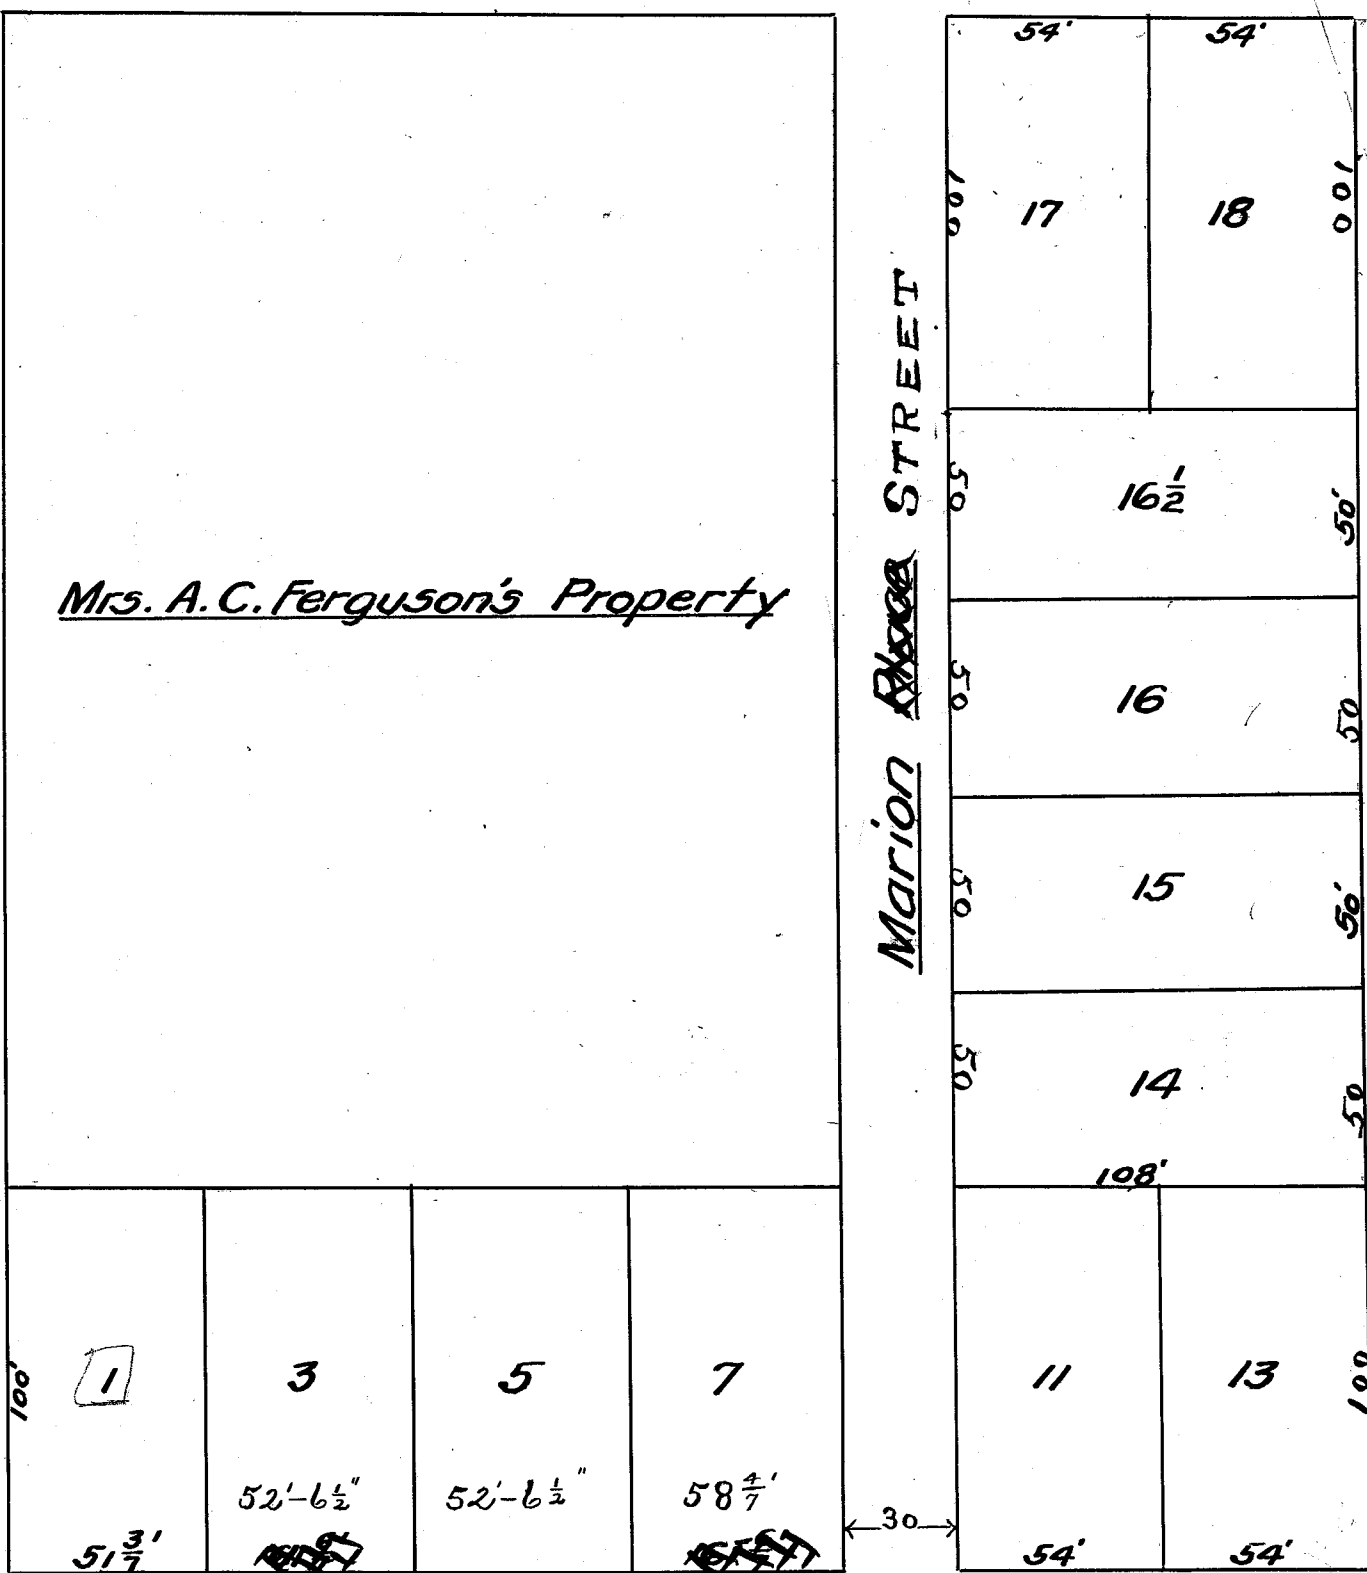

Logan Street

N. 71° 30' E

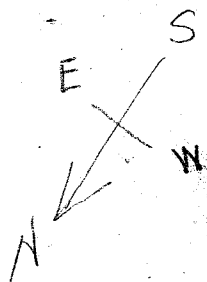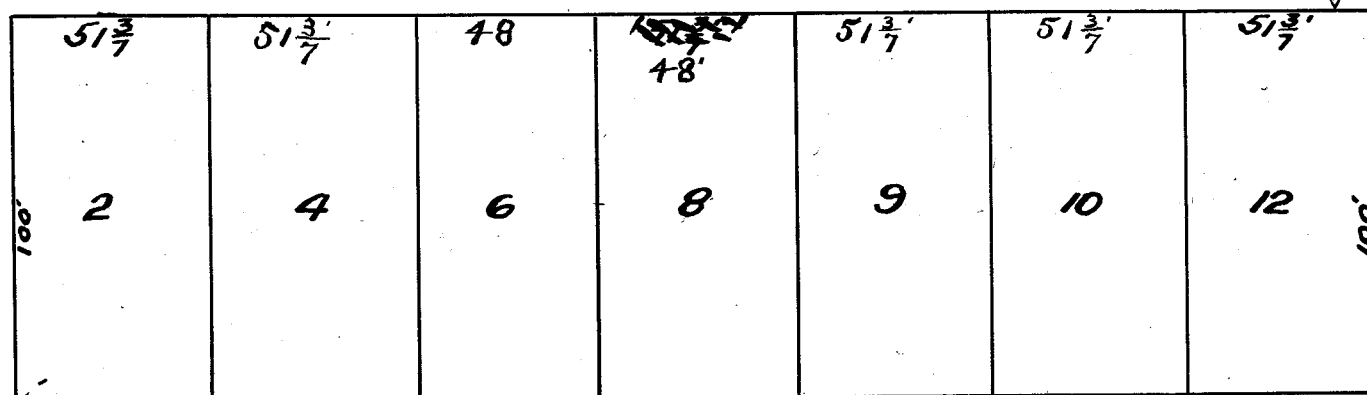

lots 1 to 13 bought of
Garratt & Hurlings
lots 14 to 18 bought of
of C. H. Johnson

LAND OF
WM. G. SIRRINE
IN WEST GREENVILLE

SCALE 1" = 50'

PLATTED JULY 8, 1907.

R.M.M.