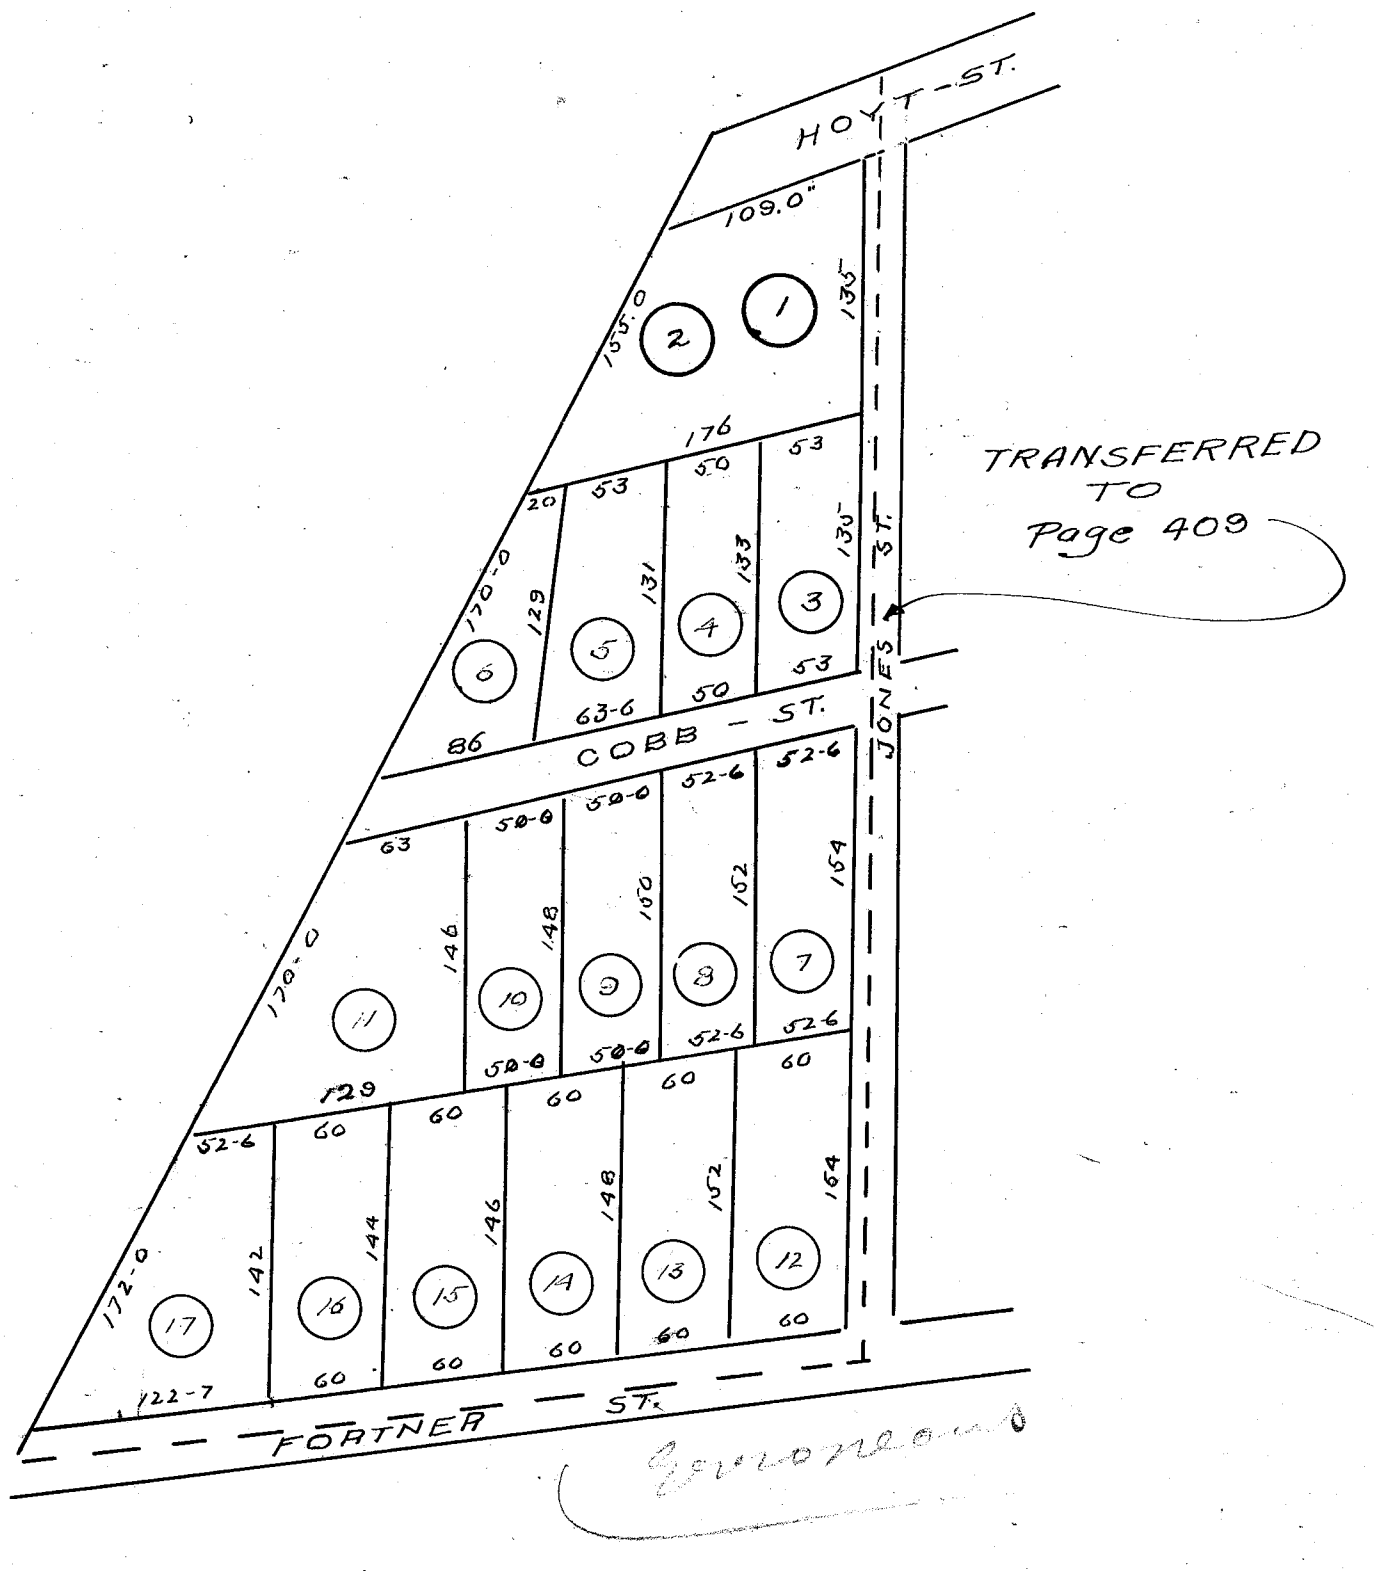

— PROPERTY - OF - J. E. BURDEN —

— TRANSFERED FROM PAGE 305 —