


Plat

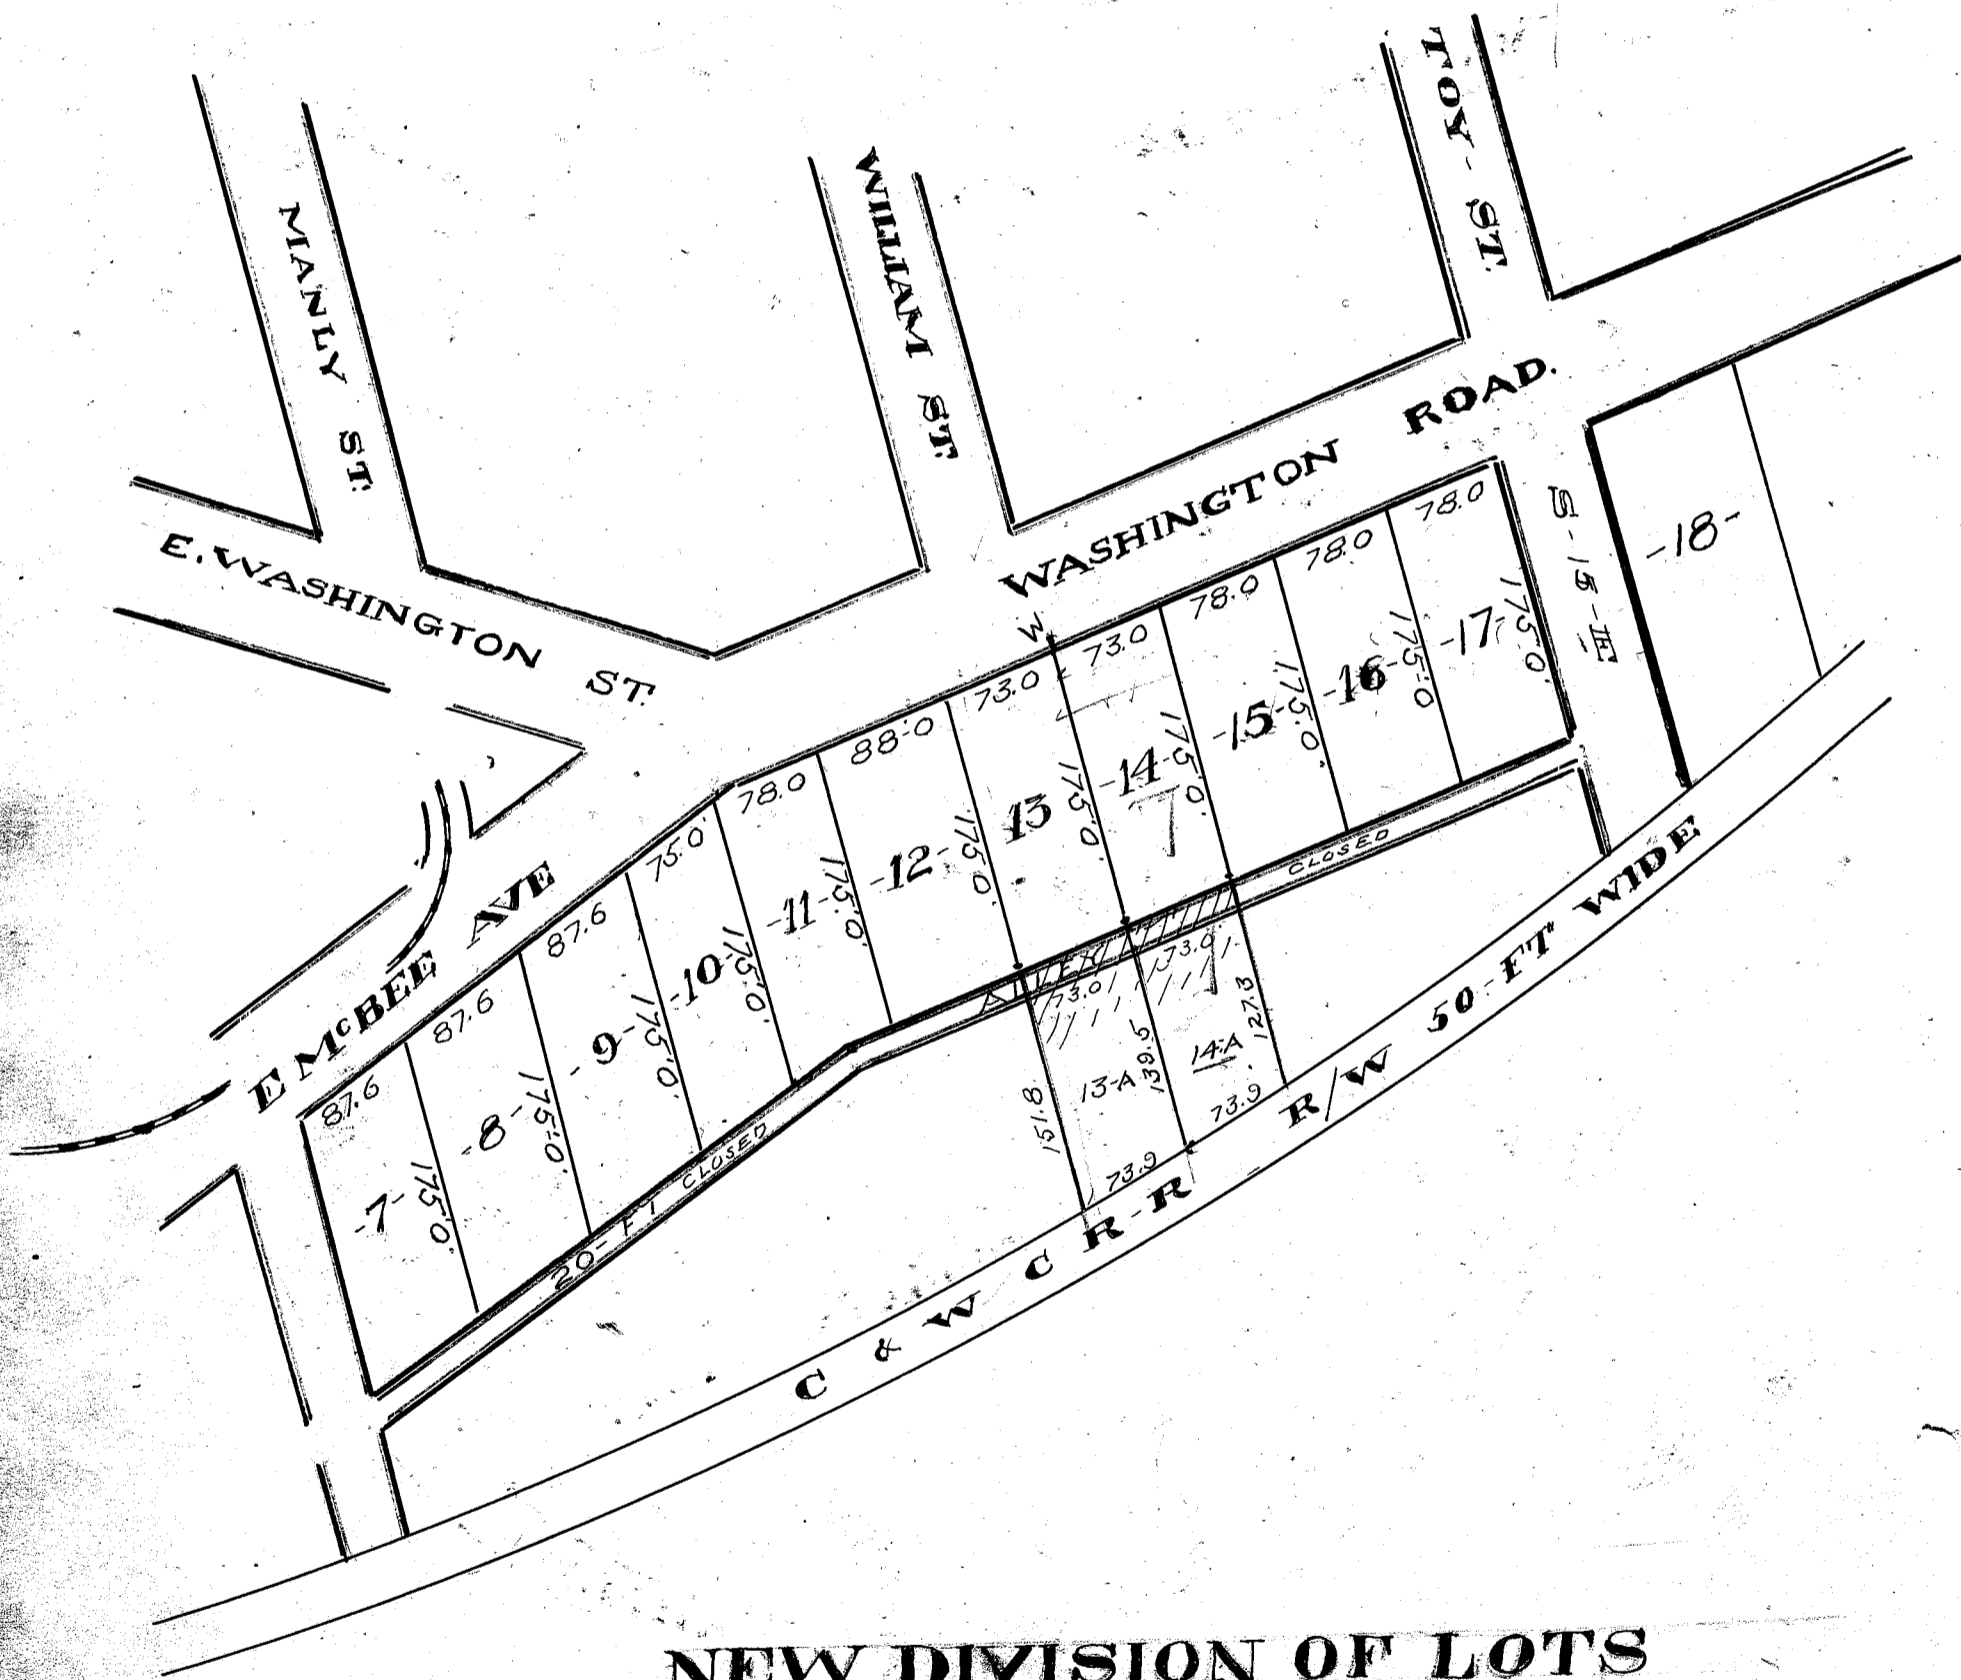

NEW DIVISION OF LOTS
12-13 AND 14
SEE NEXT PAGE

Plat-185