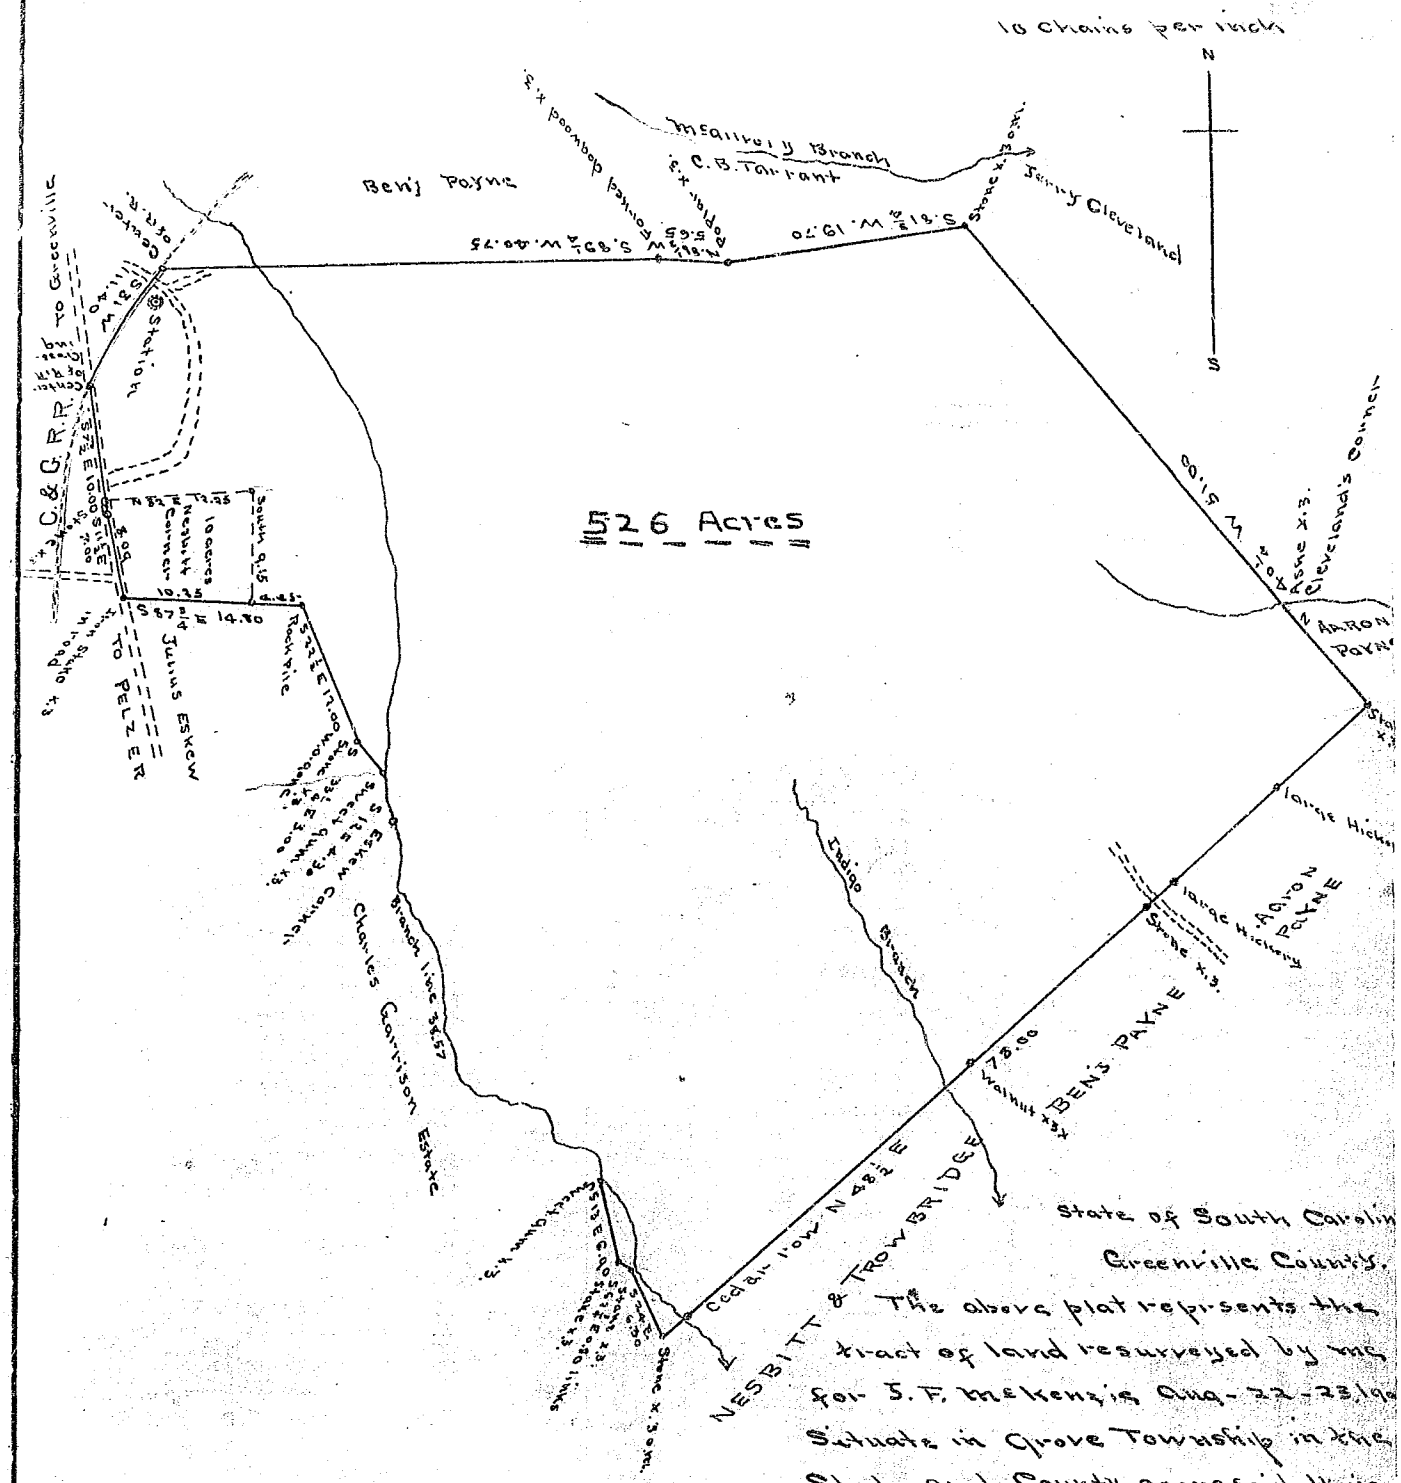

State of South Carolin
Greenville County.

The above plat represents the
tract of land resurveyed by me
for S. F. McKenzie Aug-22-23/90
Situate in Grove Township in the
State and County aforesaid, lying
on East side of C. & G. R. R. at
Golden Grove and I find it to
Contain Five Hundred and twenty
six (526) acres, and to have such
form, marks and boundings as
represented by the above plat.
This Oct-8-1909.

Wm F. Lee, Surv.
Copied by Black
Backs

June-24-1914.