


47

Surveyed June 1917.  
Note:- Iron pipes at All corners,  
except as noted.

ELFORD STREET

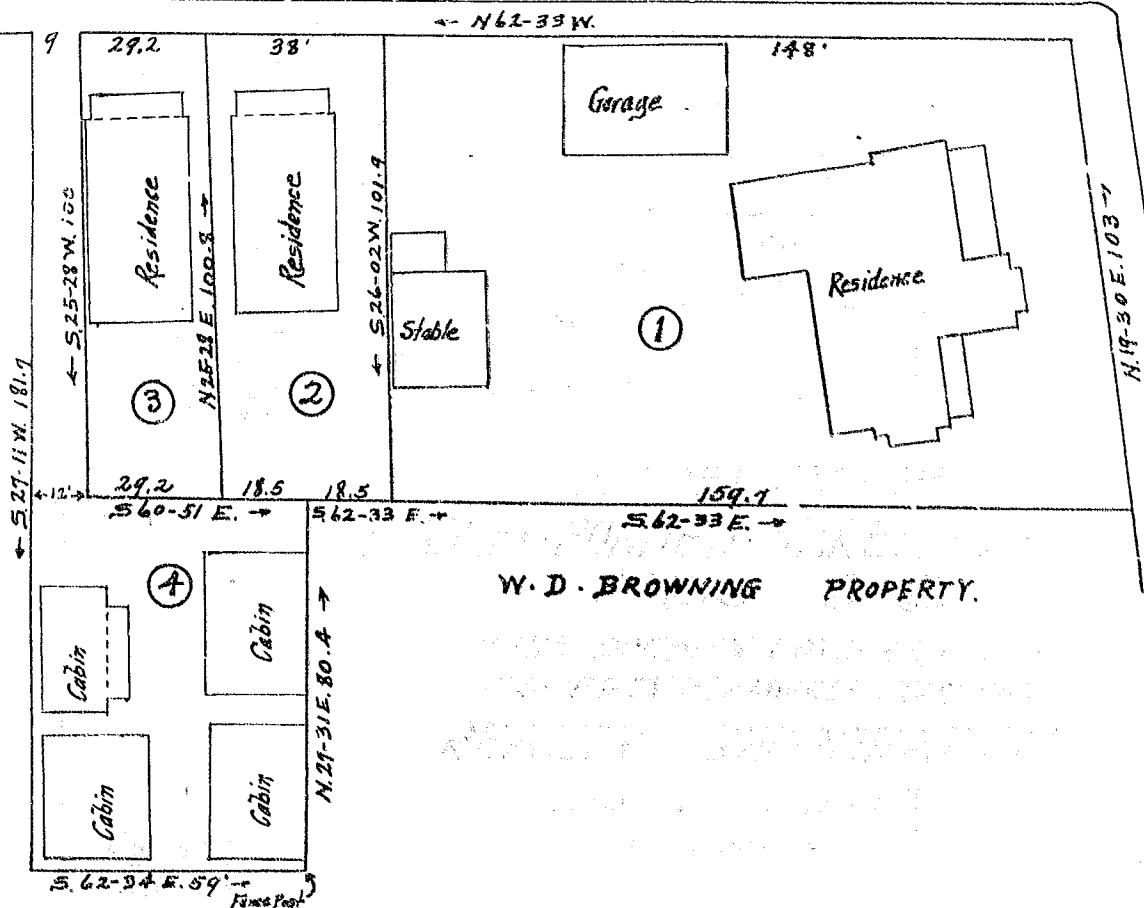

W. D. BROWNING PROPERTY.

Estate of John H. O'Neal,

Main Street, Greenville, S.C.- Scale 1"= 30'

R.E. Dalton, Engineer, July 1917, Greenville, S.C.

Recorded July 16th,- Copied and Certified to by James R. Bates, R.E.C.