


94

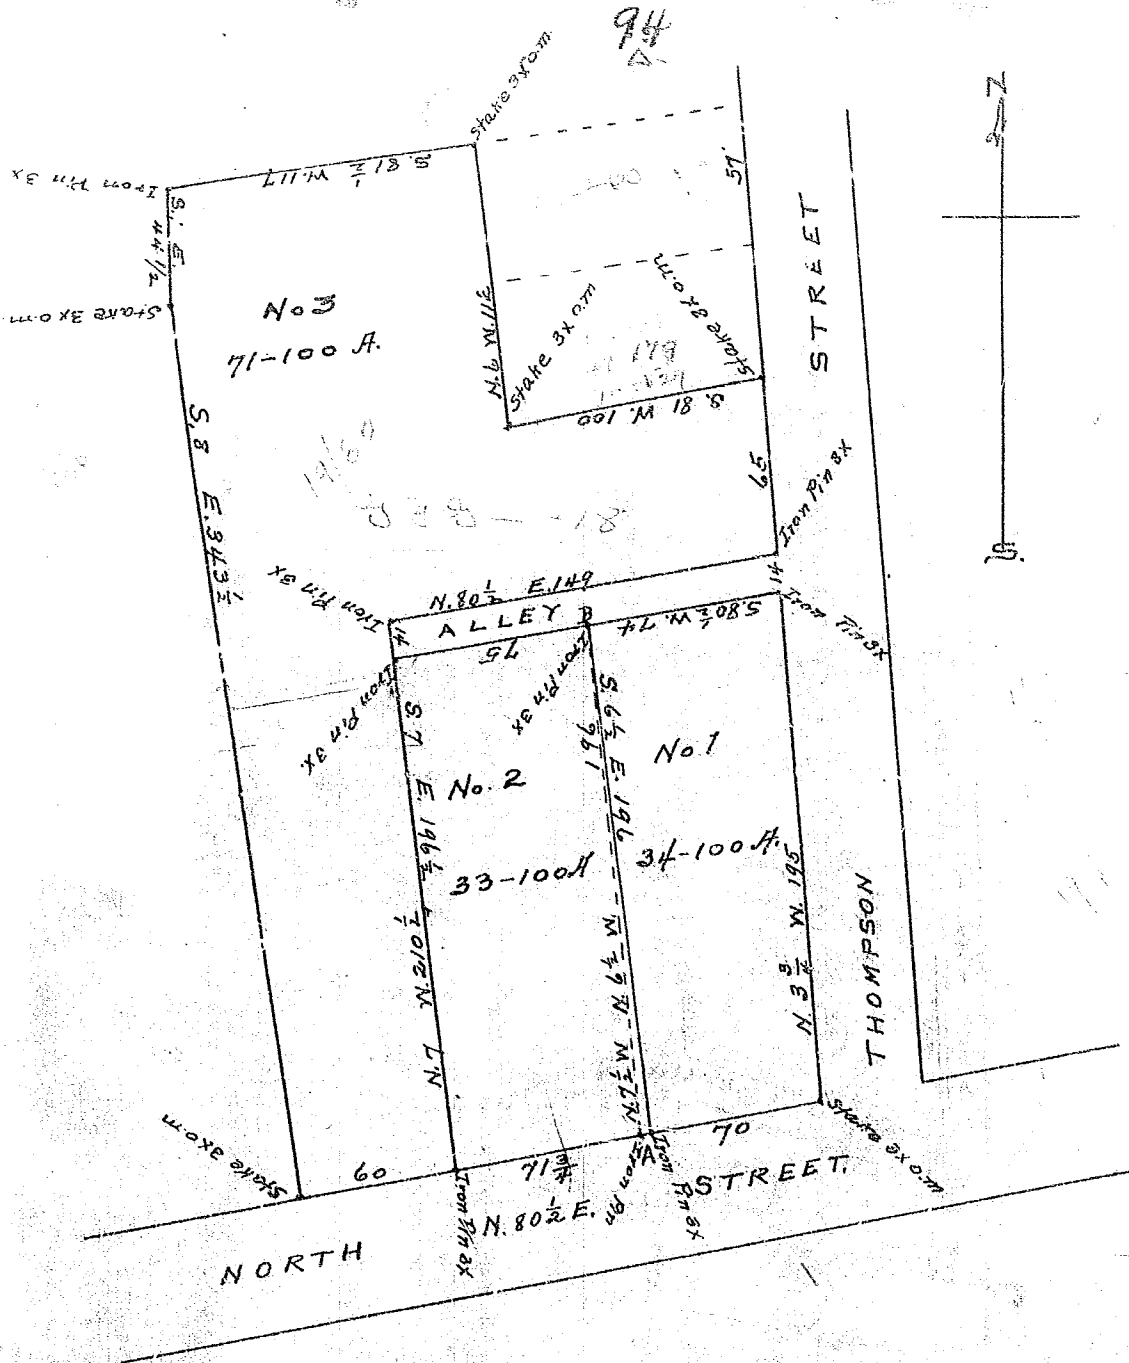

A division of the Ferguson Lot on the north side of North Street and west side of Thompson Street, in the city of Greenville, S. C.

Note: - The dotted line A-B. represents a change made in the original plat by taking 3 1/2 feet of the front of Lot #2 and adding same to Lot #1.

Surveyed Nov. 22nd 1899

J. W. Southern, D.S.

Recorded Aug. 30th 1918

By James H. Bates R.M.C.