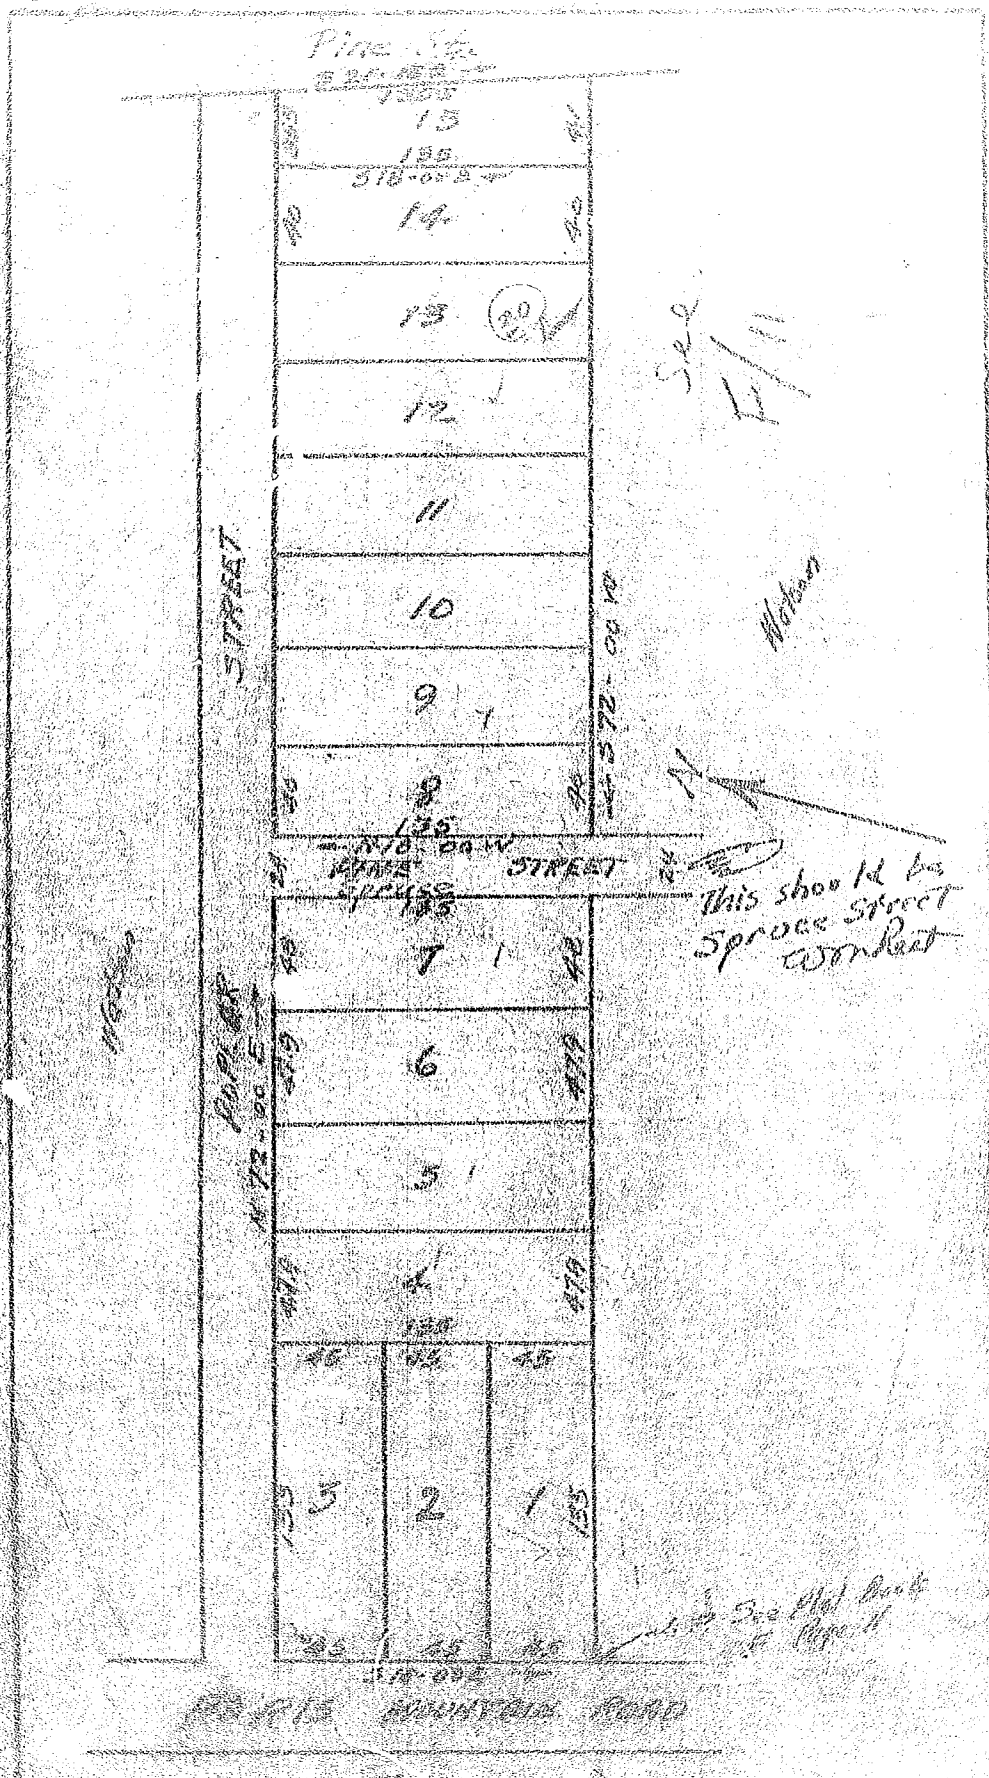
Pine St.
15
14
13
12
11
10
9
8
7
6
5
4
3
2
1
This should be Spruce Street corrected