
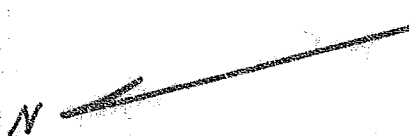


SHOWING REVISED PLAT LOT No. 3
PROPERTY MECHANICS B & L ASSOCIATION
GREENVILLE S.C.

Scale 1" = 30' April 1980

W.M. ROOST

517.45W →

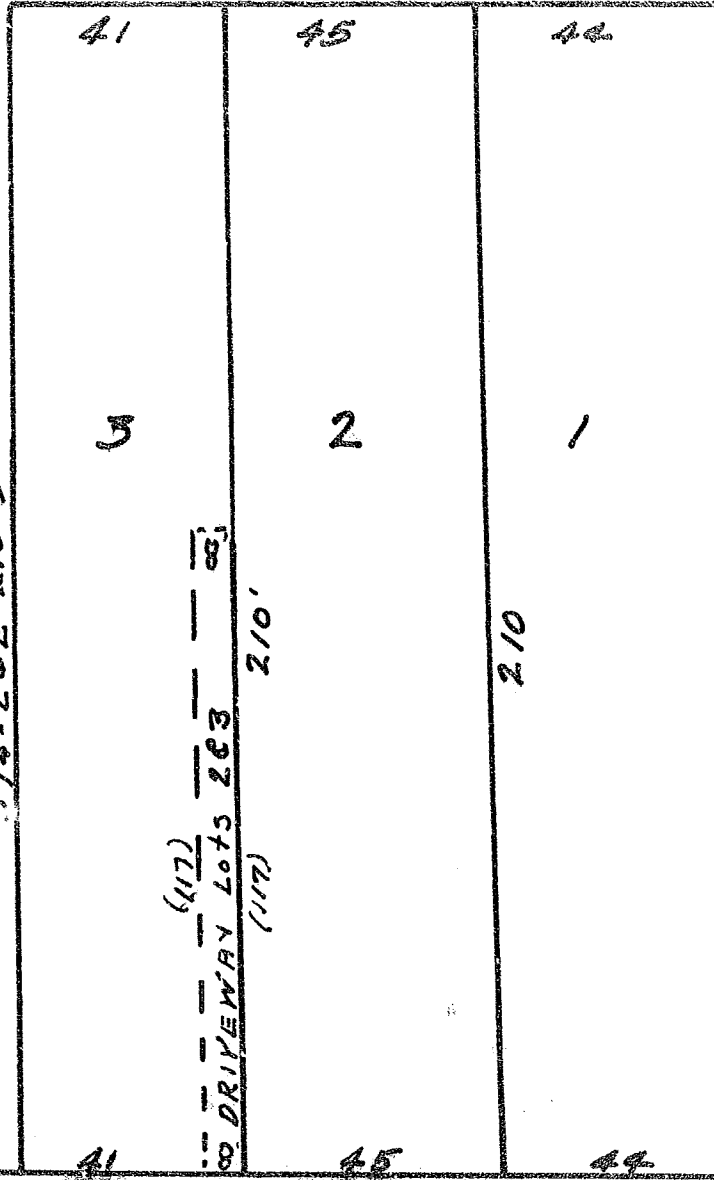

PERRY ROAD

262