Plat Book H Page 112

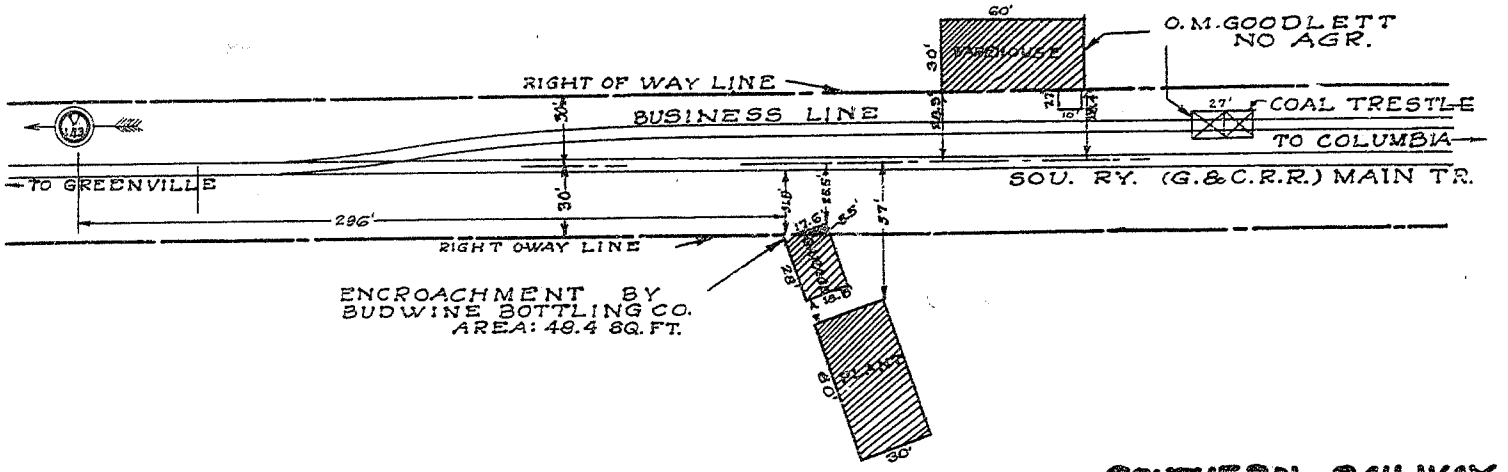

SOUTHERN RAILWAY CO.
EASTERN · DIST.
CHARLOTTE · DIV.
GREENVILLE · S · C ·
PLAN SHOWING ENCROACHMENT
BY BUDWINE BOTTLING CO.
Scale 1"=50' W.J.S. Apr. 25 '24.

BAD COPY

RECORDED BY Sam Yates Jr.
DEC. 8, 1927 11:00 A.M.

131