


TRACT 7

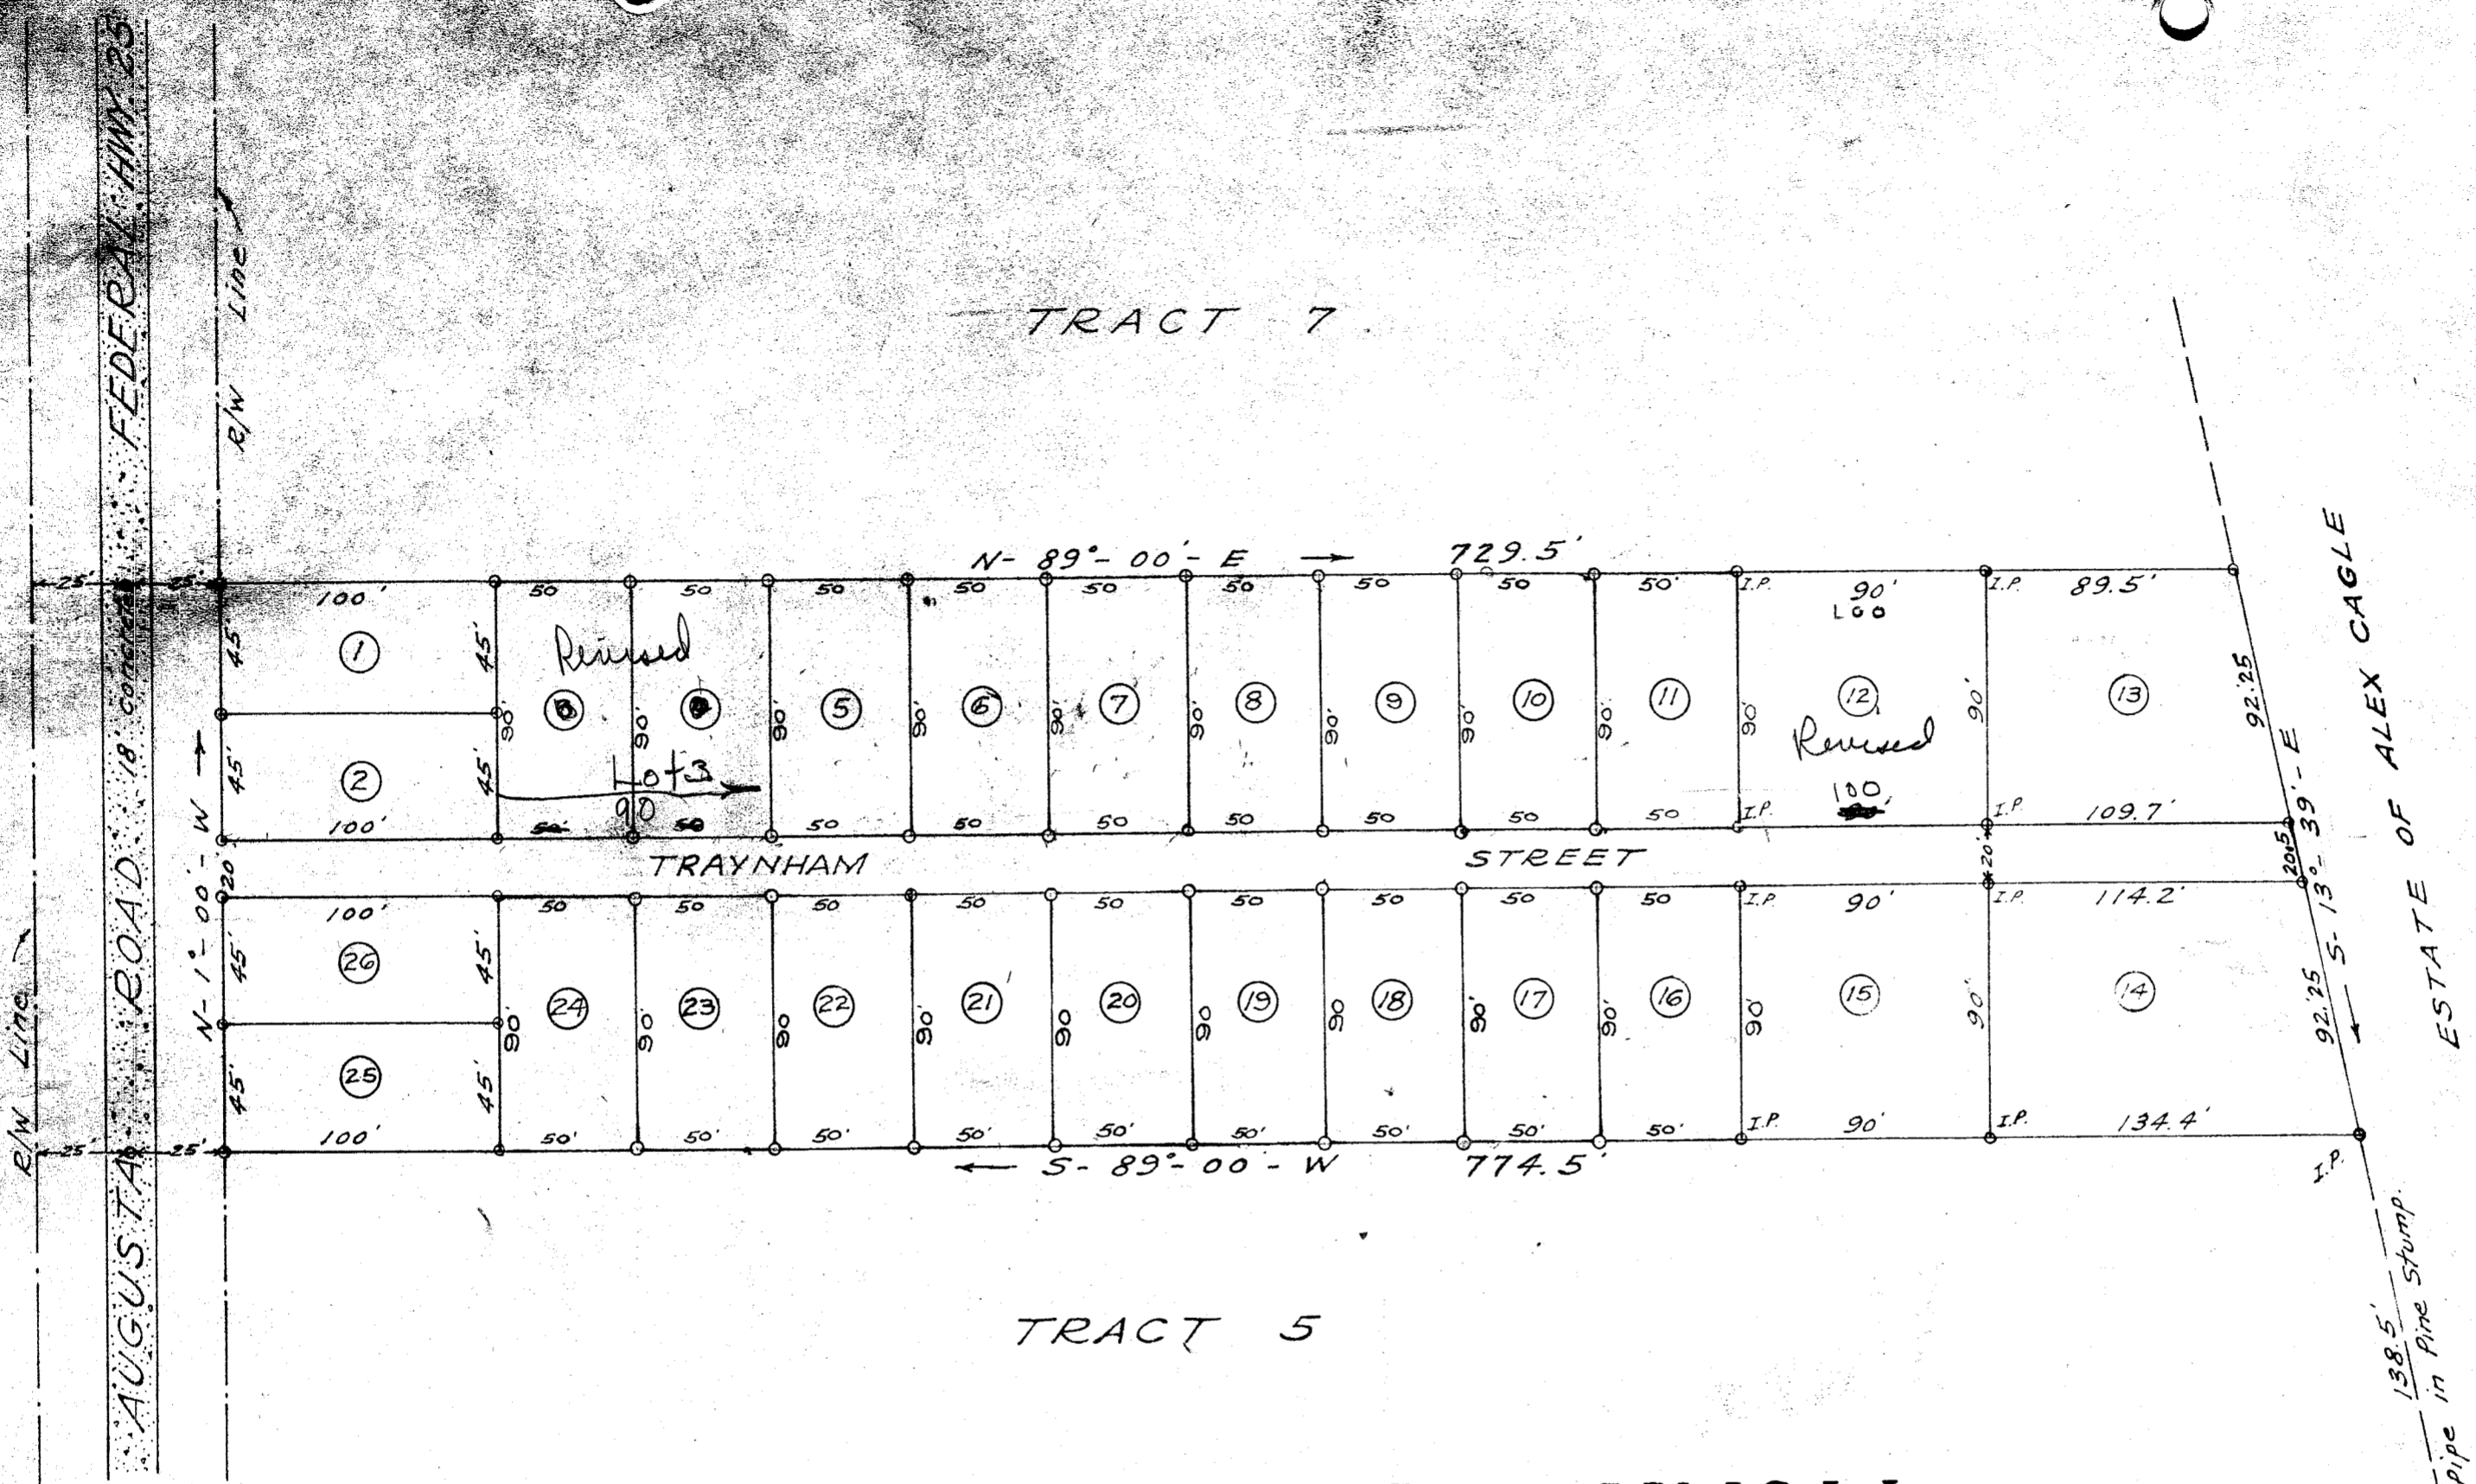

TRACT 5

AUGUSTA KNOLL
 PROPERTY OF
TRAXLER REAL ESTATE CO.
 GREENVILLE COUNTY S.C.
 DALTON & NEVES - DECEMBER, 1946.
 SCALE 1 INCH. = 60 FEET.

11819 filed This 19 day of June 1947
 And Recorded at 10:00 AM 68 at 11:35 AM
Ollie Farnsworth
 Register Means Conveyance Greenville County, S.C.

-NOTE-
 STAKES AT ALL CORNERS
 UNLESS OTHERWISE NOTED.