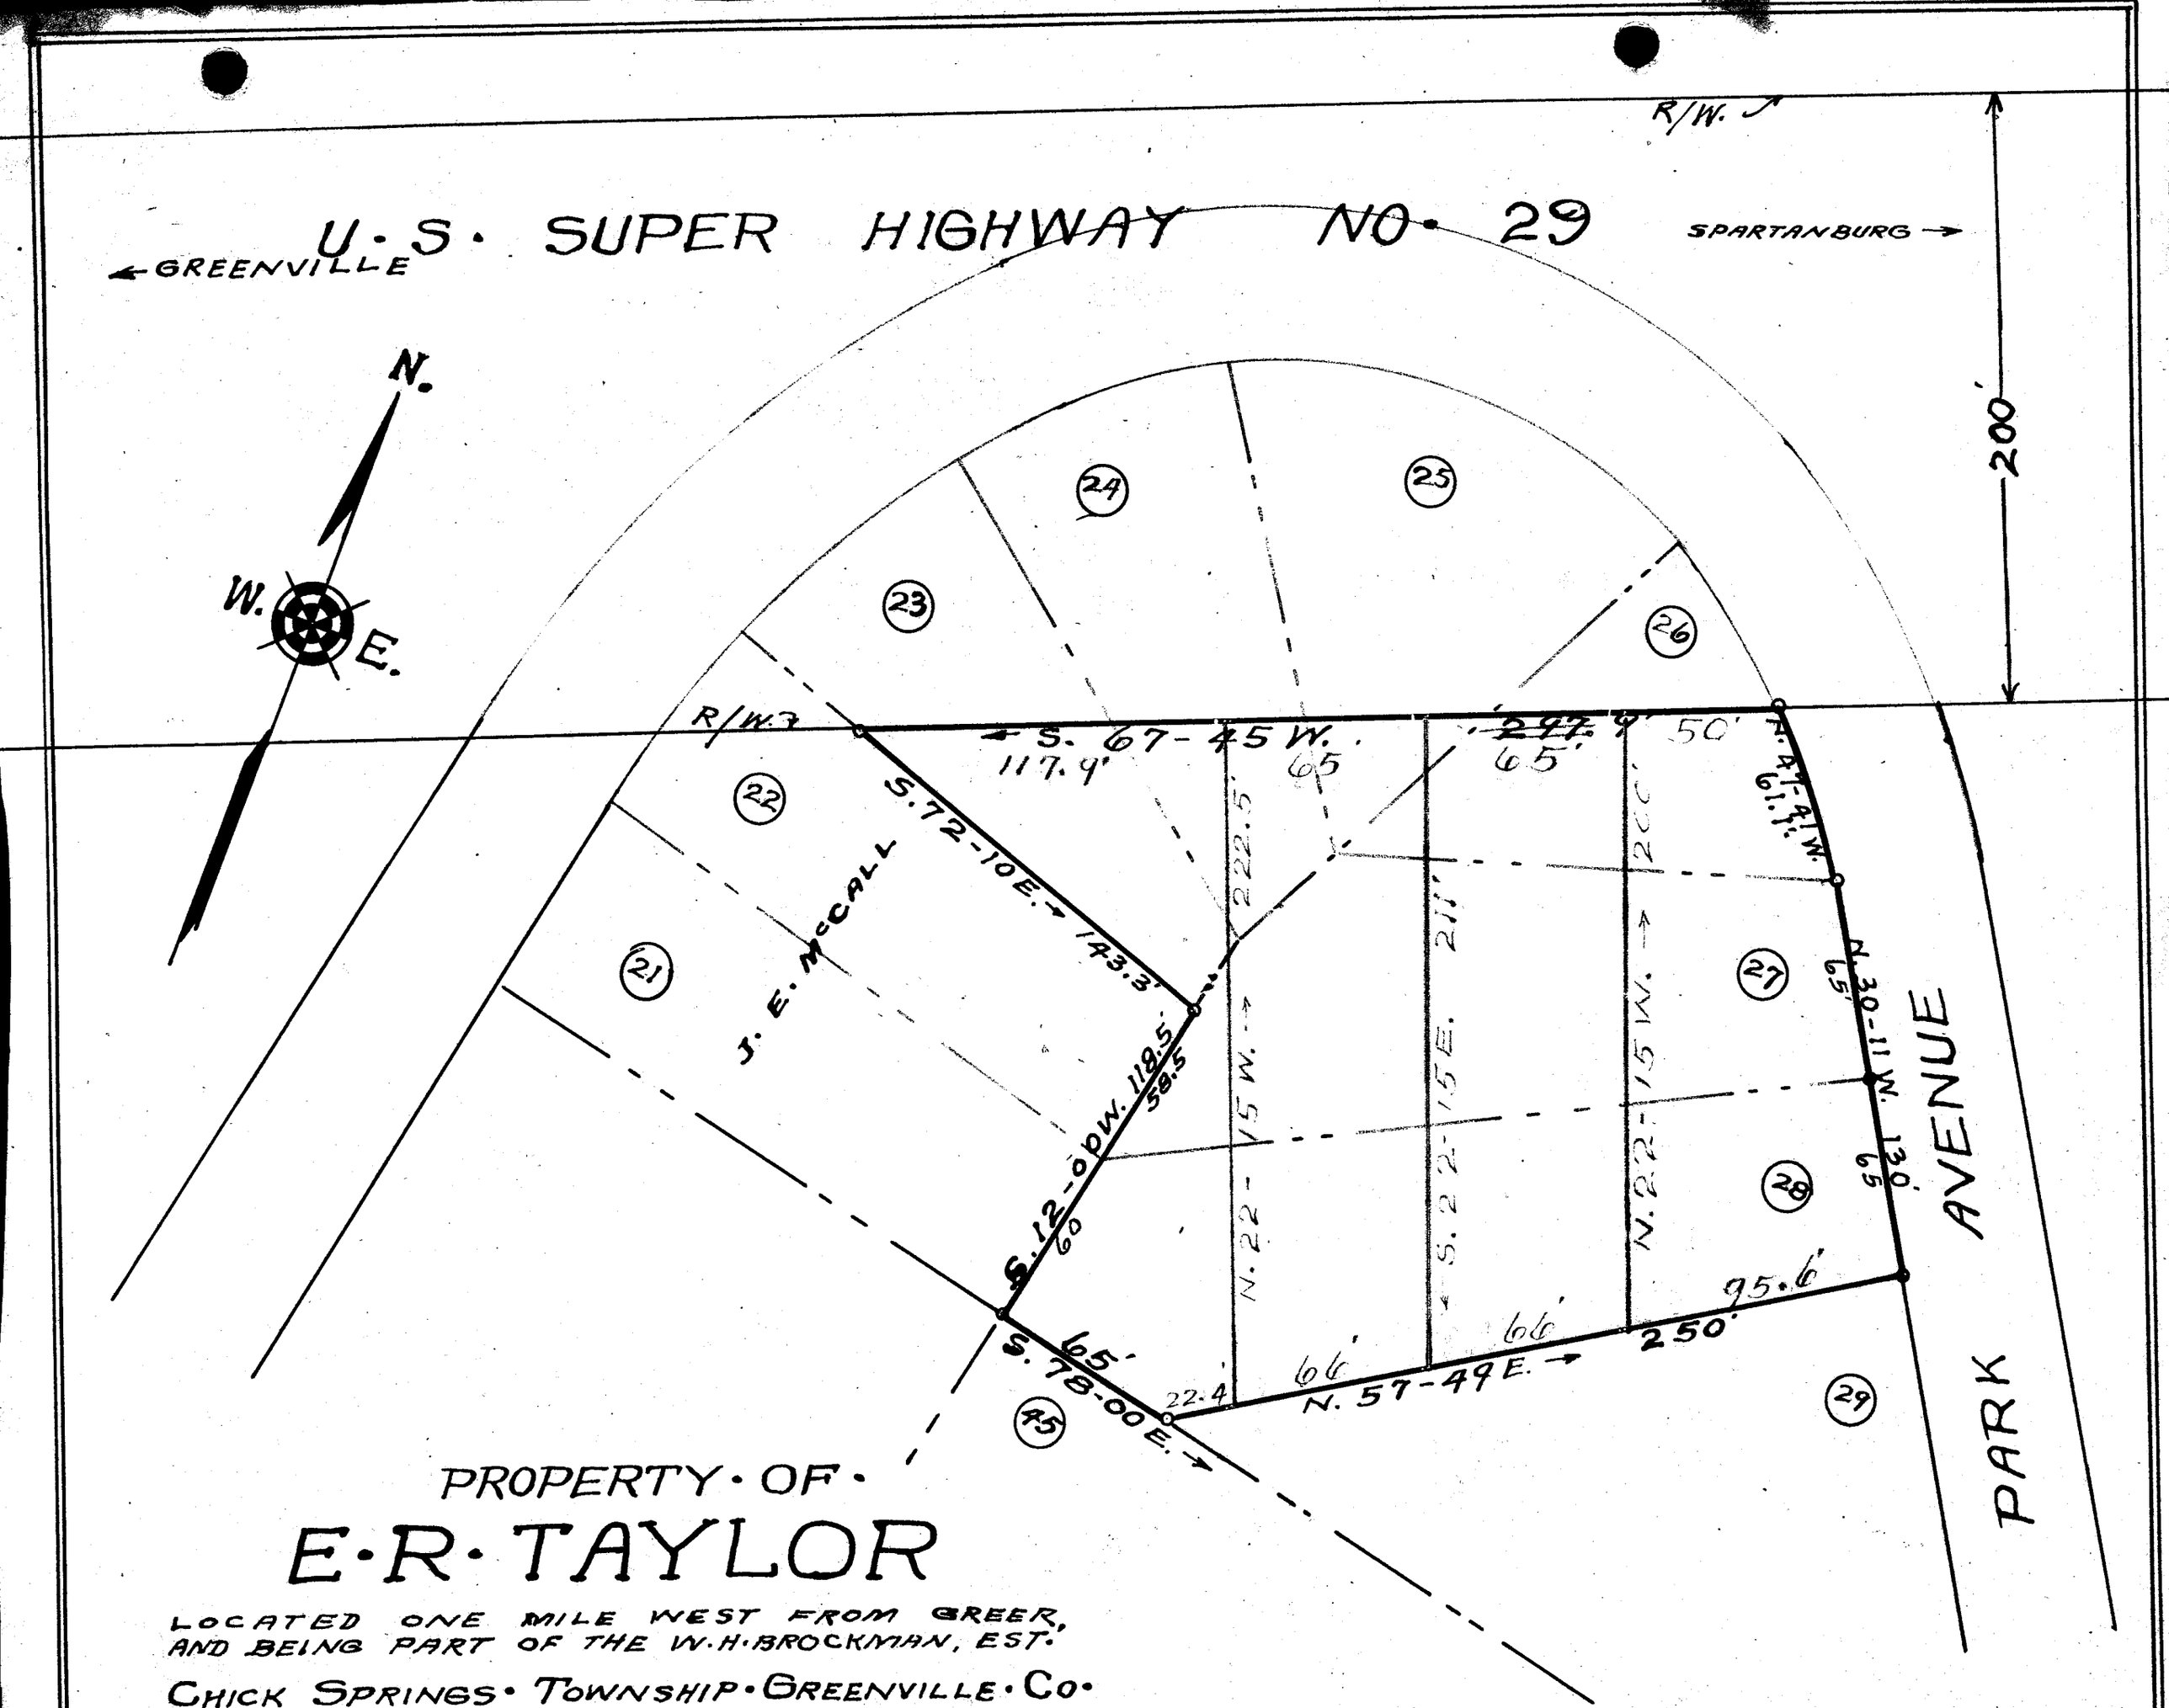

PROPERTY·OF·

E·R·TAYLOR

LOCATED ONE MILE WEST FROM GREER, AND BEING PART OF THE W.H.BROCKMAN, EST.

CHICK SPRINGS·TOWNSHIP·GREENVILLE·CO·

SOUTH·CAROLINA·

SCALE: 1" = 50·FEET· JUNE · 8 · 1942·

RE-SURVEYED JUNE·4·1942

H.S.BROCKMAN, SURVEYOR, GREER, S.C.