


6344  
 GREENVILLE  
 23 MAR 2 1946  
 ENGINEERING  
 S. C.

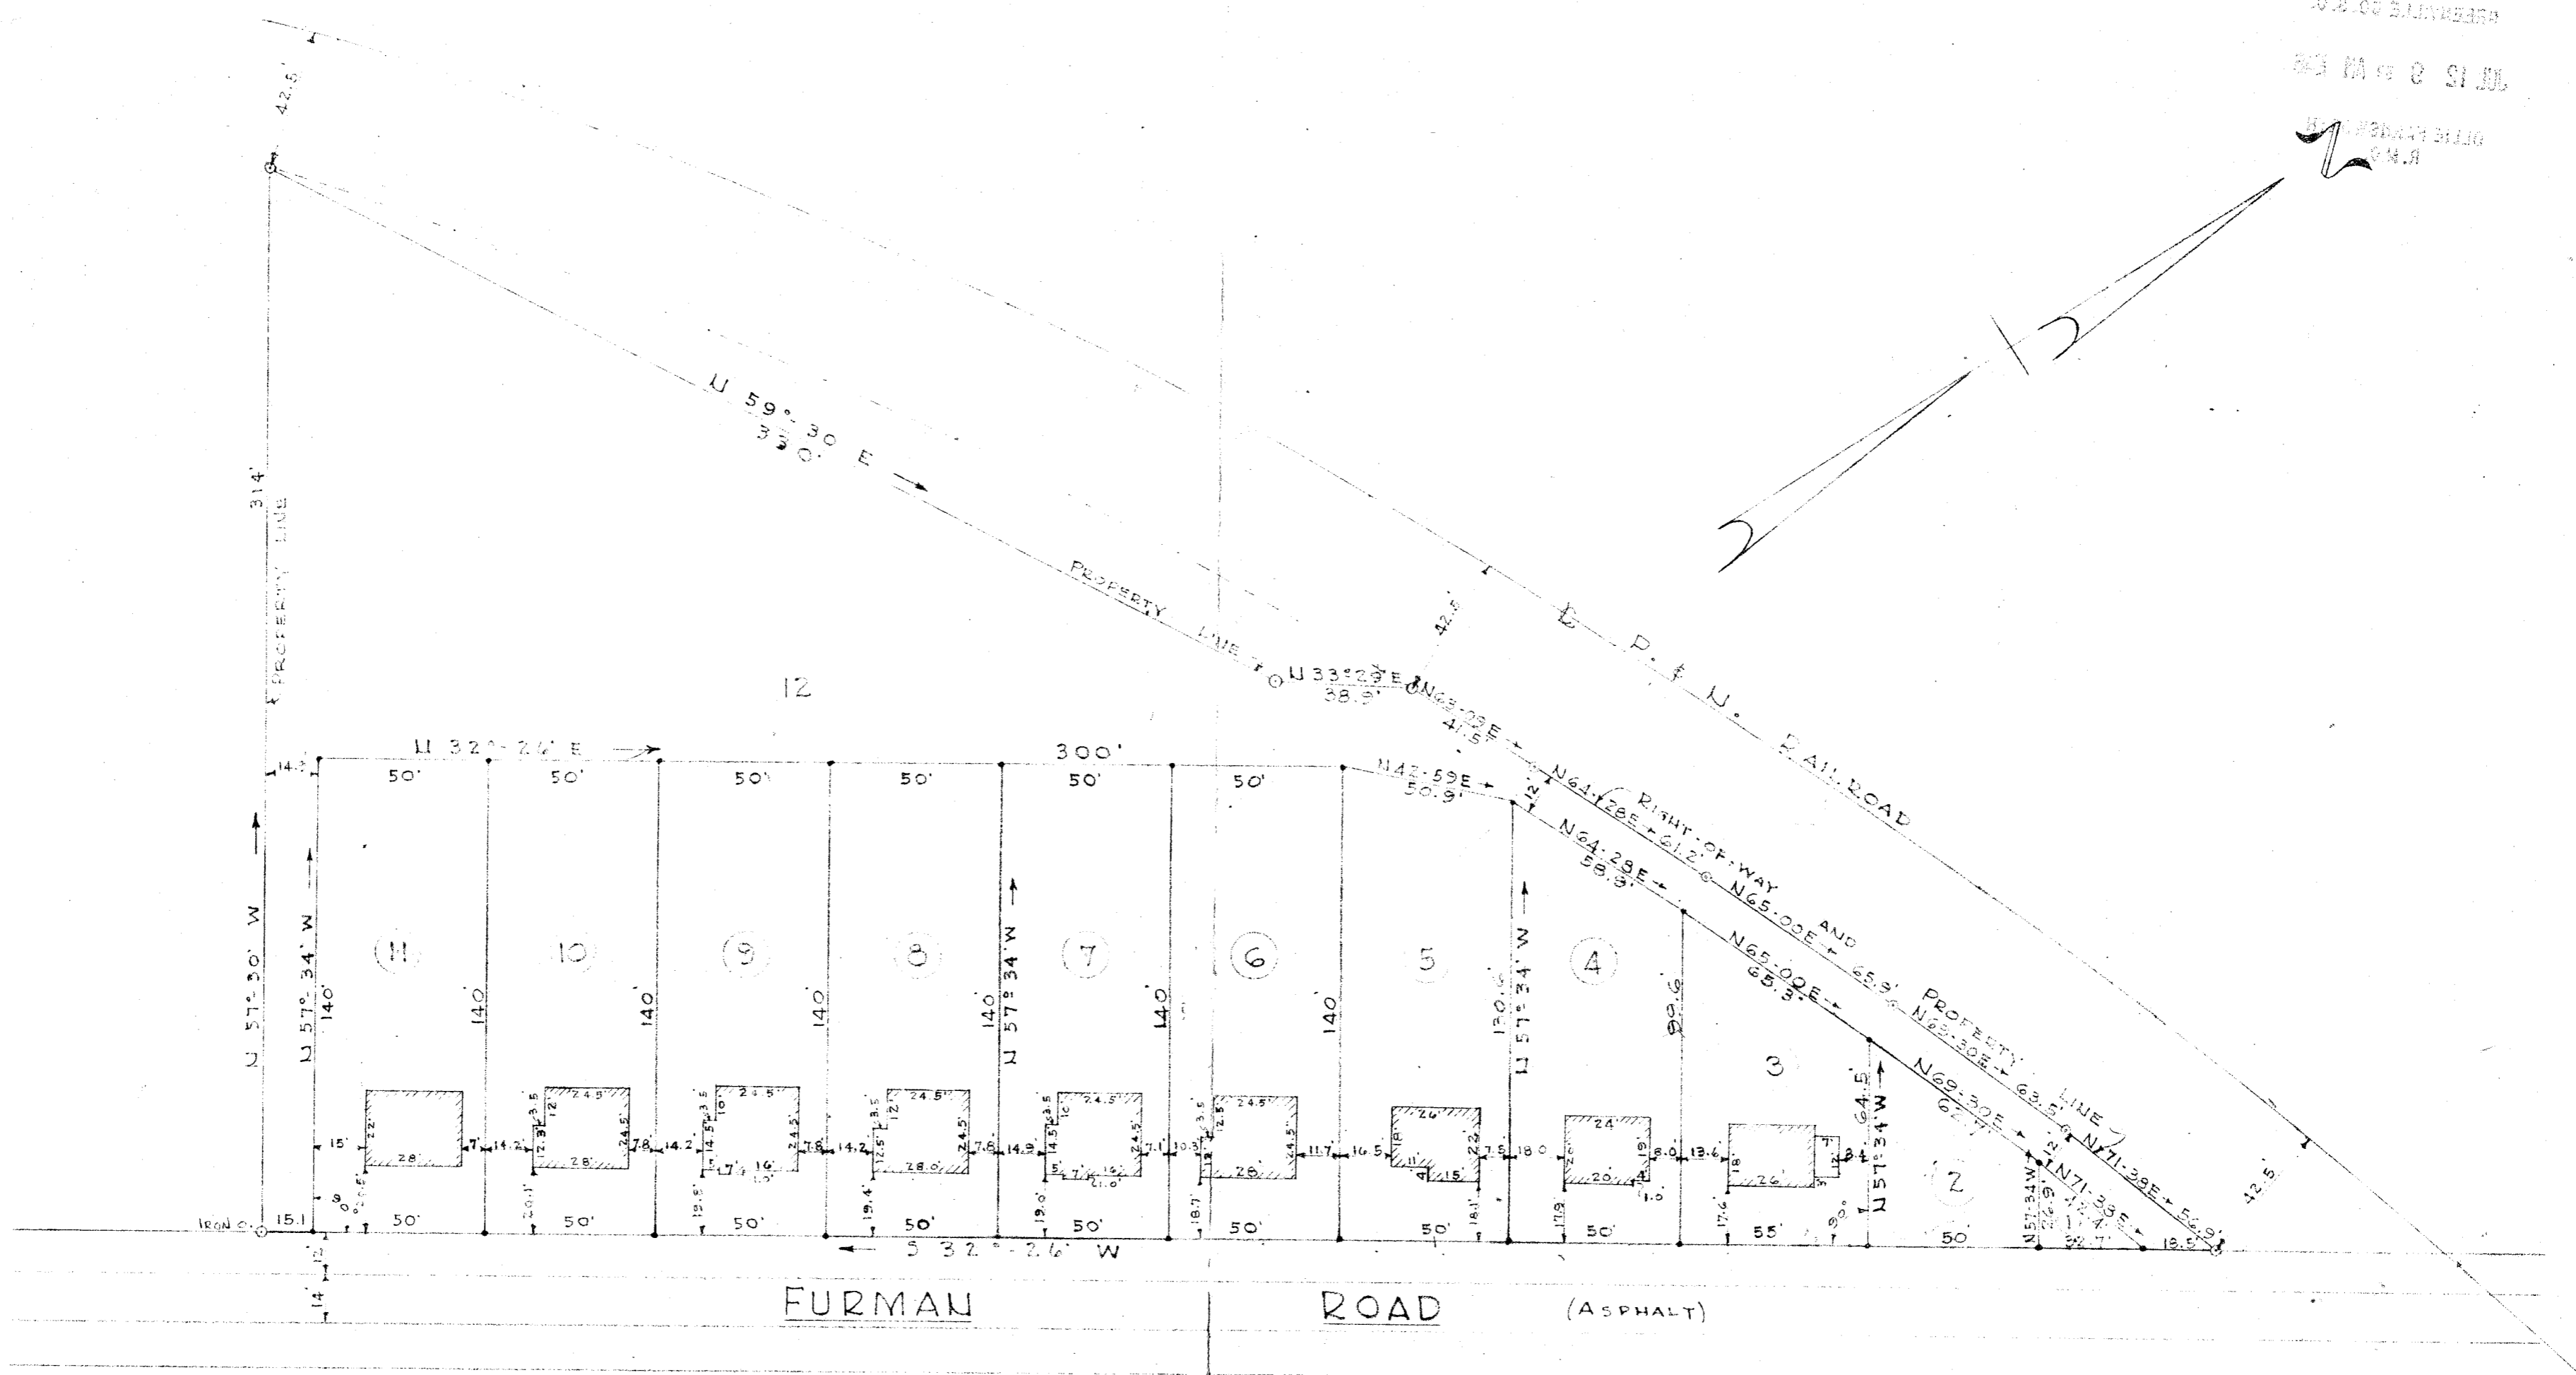

PROPERTY OF:  
CENTRAL REALTY CORPORATION  
 LOCATED IN GREENVILLE TOWNSHIP, GREENVILLE COUNTY, NEAR THE  
 CITY OF GREENVILLE, S. C.

PICKELL & PICKELL — ENGINEERS  
GREENVILLE - S. C.

SCALE: 1" = 40'

DATED: APRIL 30, 1946

Approved by Planning Commission  
 Aug. 16, 1946

*J. Mac Richardson*  
 Secy.