
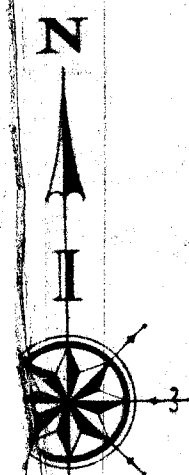


175
128
47

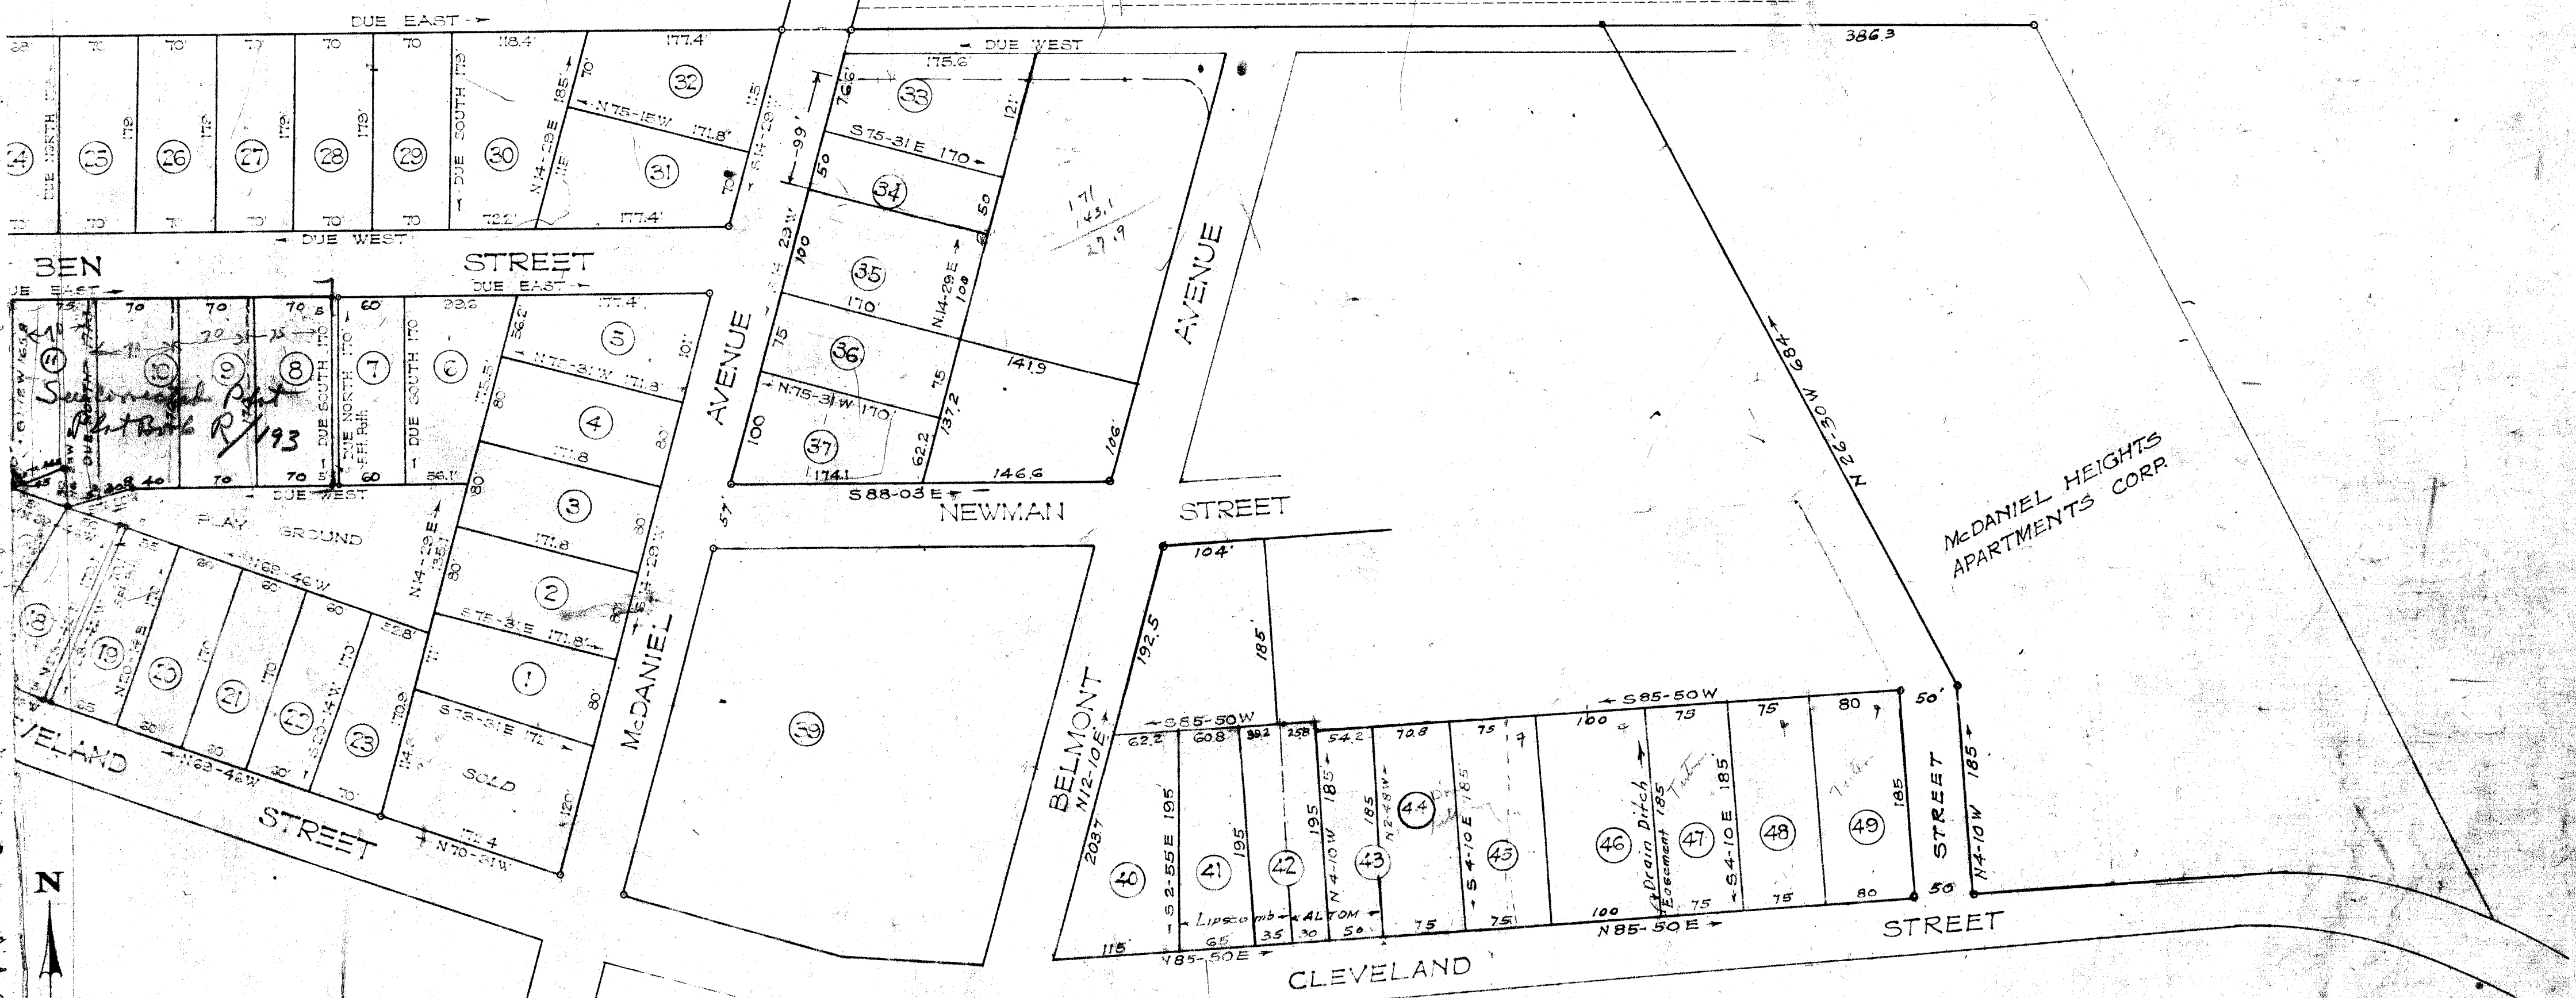


Note: Revision of Lots 33 to 37 made July 1932
 Addition of Lots 43 to 51 inclusive made Feb. 1938
 Revision of Plat McDaniel, Cleveland and Ben Sts.
 made Sept. 1946

PLAT OF
McDANIEL HEIGHTS
GREENVILLE S.C.

SEP 20 1946

15944

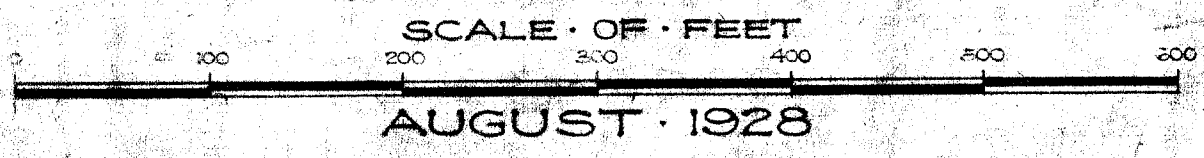

AUGUST 1928

DALTON & NEVES ENGINEERS

#15944 Filed This 20 day of Sept. 1946
 and recorded in Vol. 9 Page 87 of M.
Oliver Farnsworth
 Register Meane Conveyance Greenville County, S.C.

