


Approved Pleasant Valley, dated April 1946
as revised Feb 1950, Nelson + Meeks

Hayes P. Johnson
J. W. Johnson
H. S. Basler
J. P. Davis
J. H. Hensley, Jr.
V. E. Armstrong

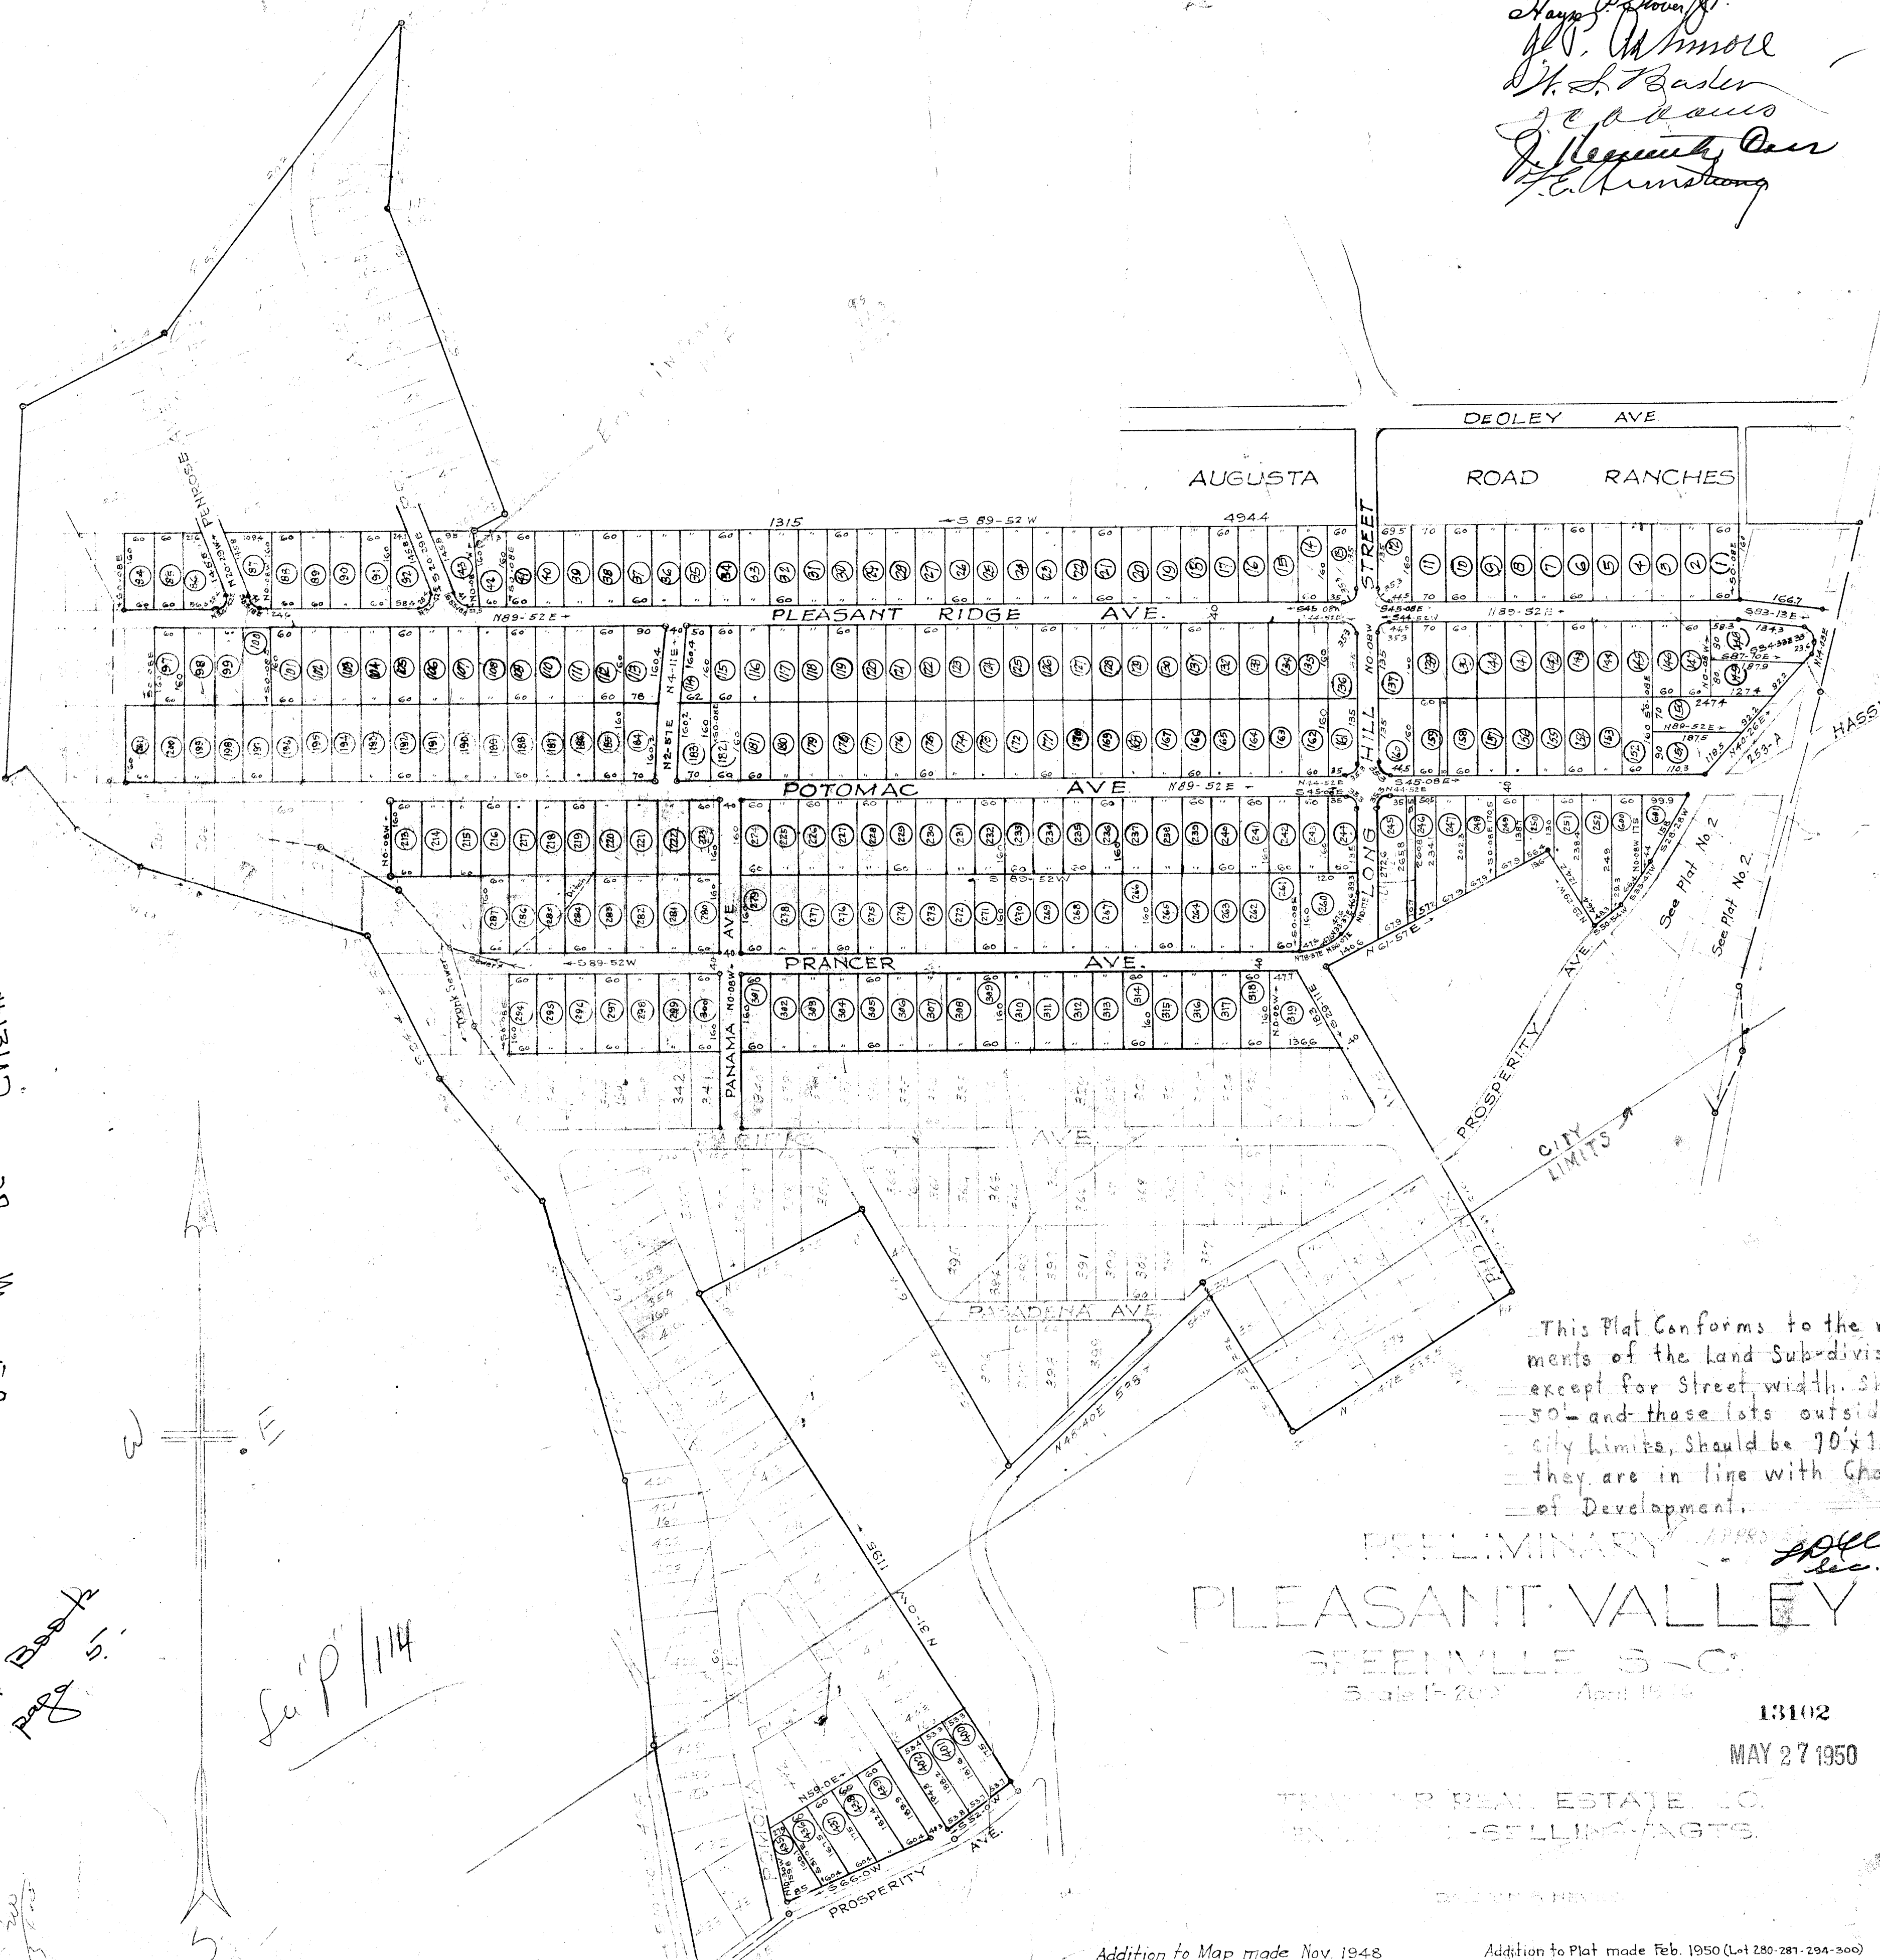

#13112
And Recorded in
Register of Deeds
Greenville County, S.C.
May 19 50

See Plat Book
EE 94 Page 51

See 'P' 1114

Lots numbered in Circles have been staked with Iron Pins

This Plat conforms to the requirements of the Land Sub-division Ord. except for Street width, should be 50' and those lots outside of city limits, should be 70' x 130', but they are in line with Character of Development.

PRELIMINARY APPROVED
PLEASANT VALLEY

GREENVILLE S.C.
Scale 1" = 200' April 1946

13102
MAY 27 1950

TRAVELER REAL ESTATE CO.
BUYING-SELLING-AGTS.

Addition to Map made Nov 1948
Addition to Map made June 1946
Lots 223-241 Nov 1948
Lots 113-114 & 183 Revised Sept 1948
" 152-246 " Aug 1949

Addition to Plat made Feb. 1950 (Lots 280-281-294-300)