

OCT 2 1947

19612

PROPERTY OF

B.F. FLYNN ESTATE

PLAT NO. 1.

CHICK SPRINGS TOWNSHIP GREENVILLE CO.

SOUTH CAROLINA


SCALE 1" = 100 FEET MAY 9 1947

SUB-DIVIDED APRIL 30 1947

H.S. BROCKMAN, Surveyor
GREEN, S.C.

#14612 filed this 2 day of Oct 1947
And Recorded in R 81 at M.
Ollie Farnsworth
Register Mesne Conveyance Greenville County, S.C.

NOTE:
THIS SUBDIVISION CHANGED SLIGHTLY
FROM BROCKMAN SURVEY - PLAT REVISED
AND RE-DRAWN - LOTS RE-NUMBERED
JUNE 25, 1947
BY H.L. DUNHAM, Surveyor
WINDER, GA.
GA REG #277.

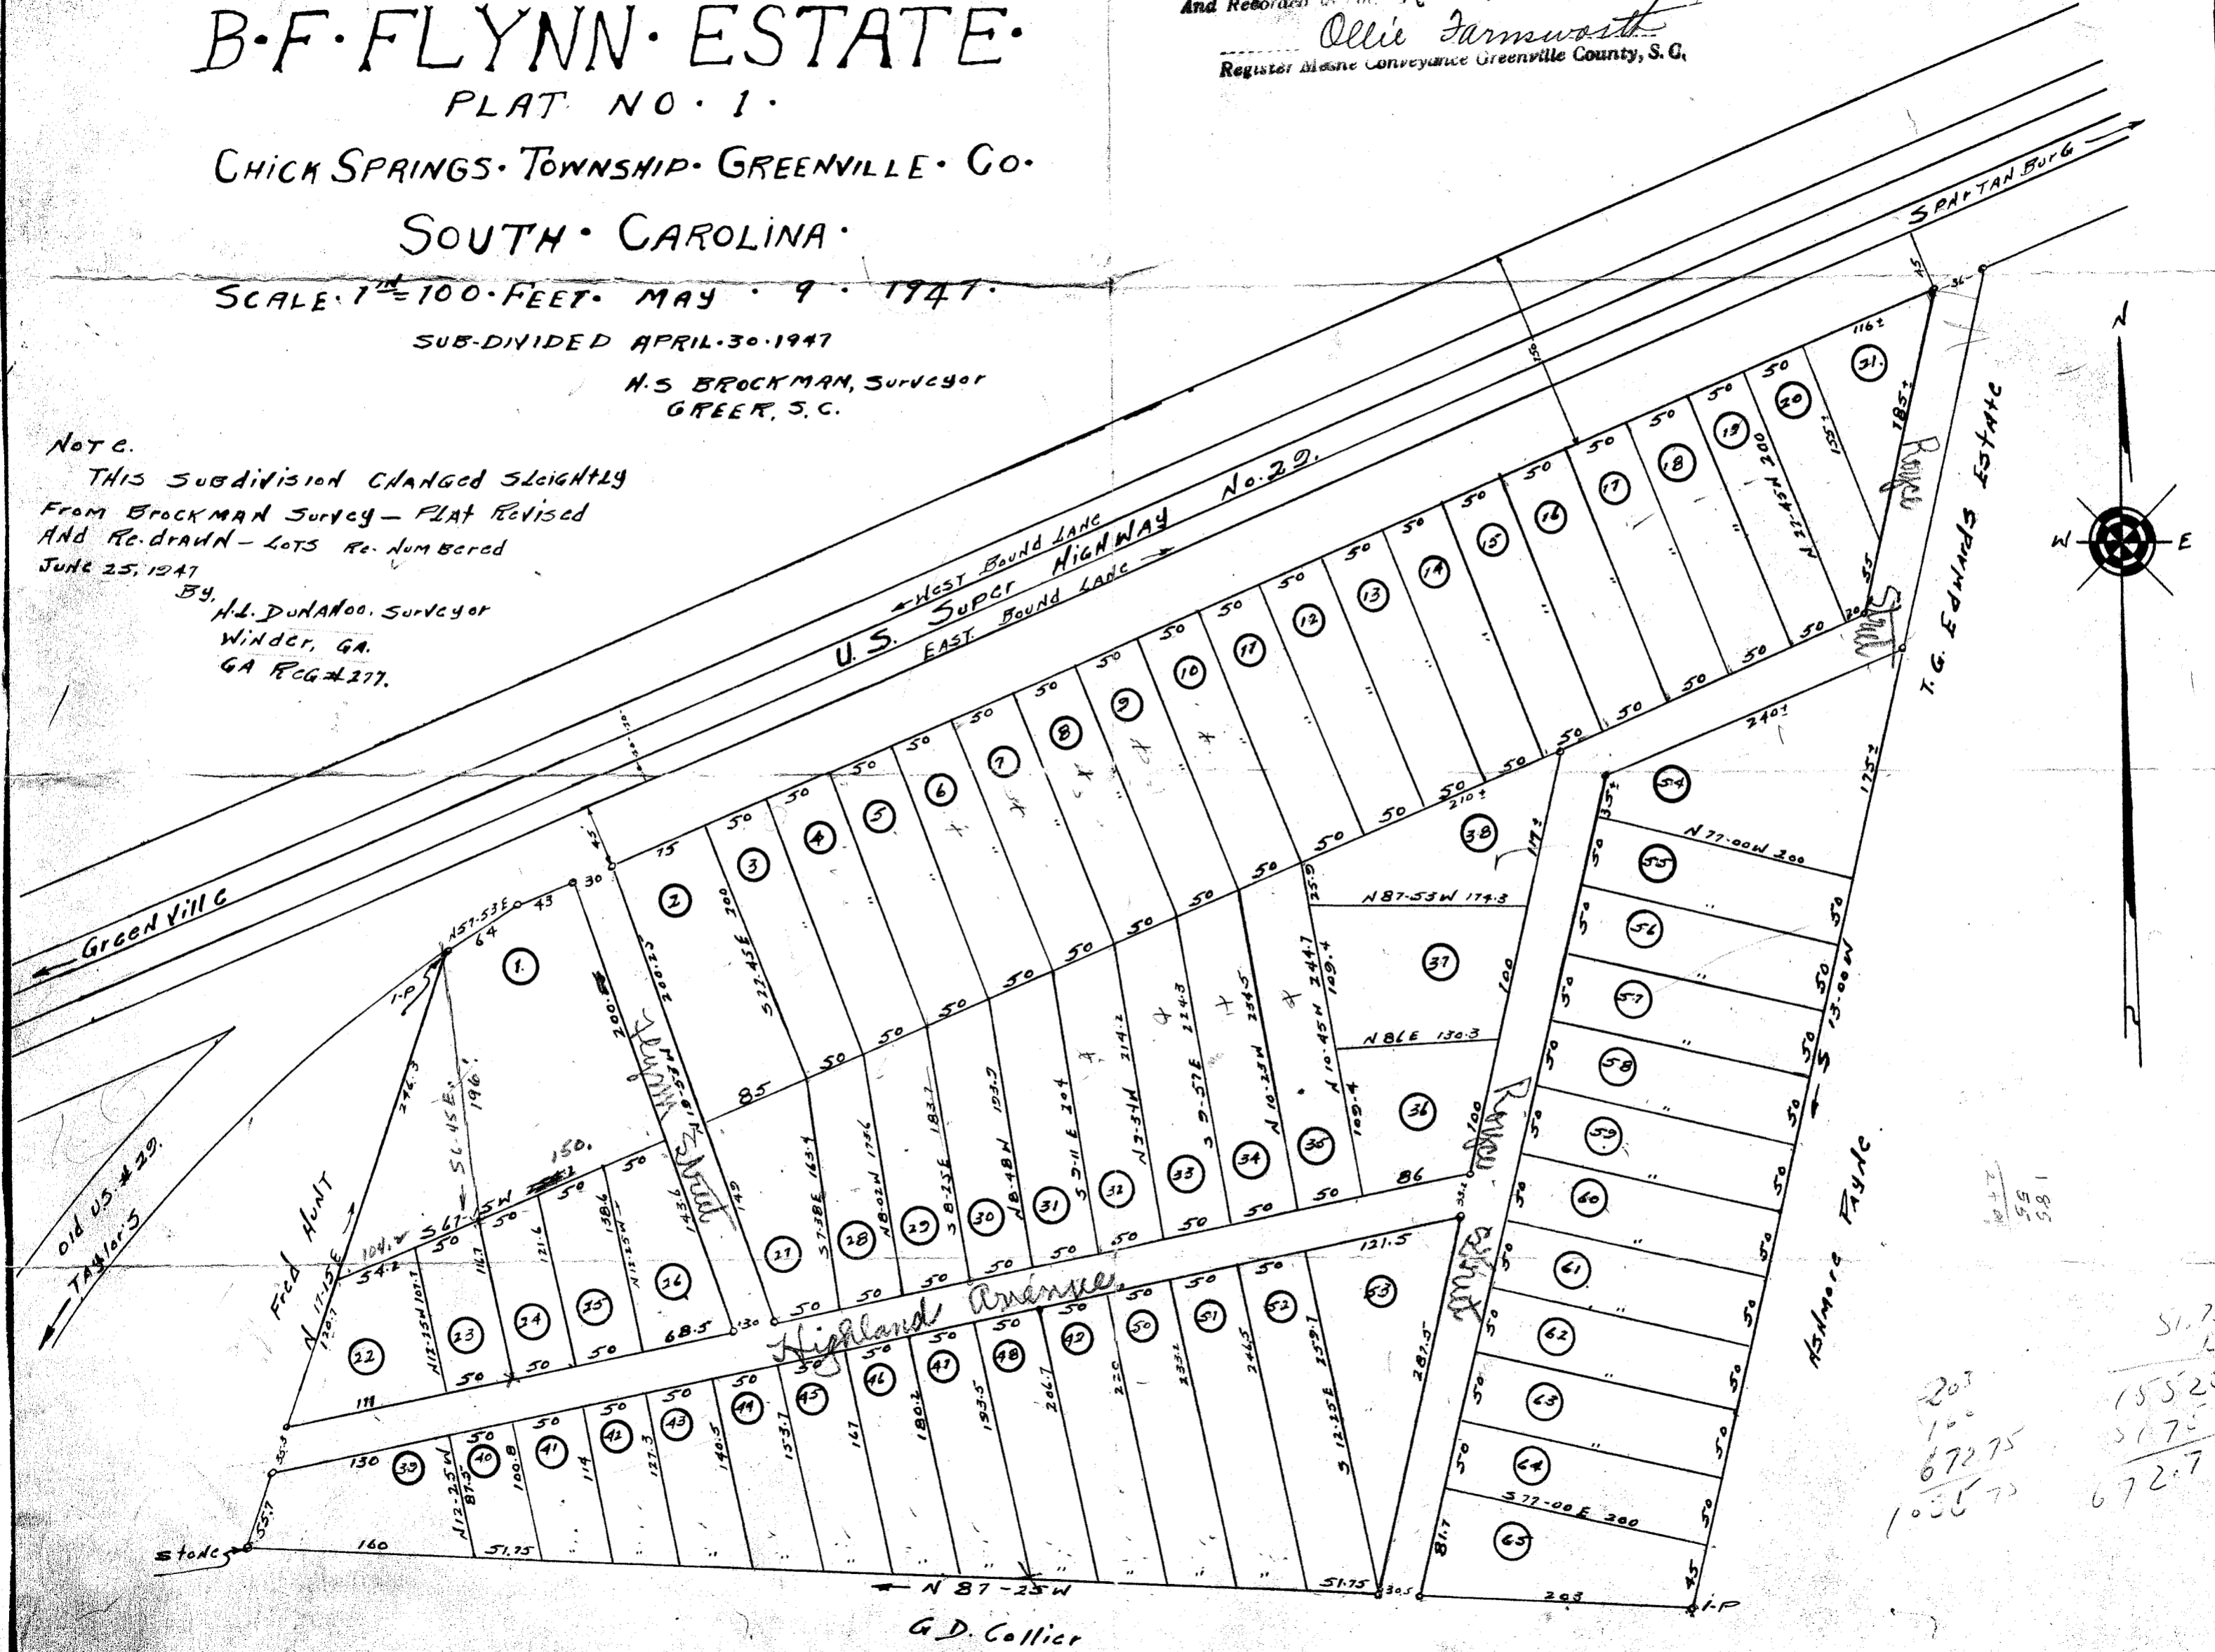

51.75
100
672.75
1035.75
1552.50
517.50
672.75