


0+50 0+60 0+70 0+80 0+90

FILED
GREENVILLE COL. S. C.
JAN 8 11 01 AM 1949
OLLE FARNSWORTH
R. M. C.

El. 100

117

JAN 8 1949

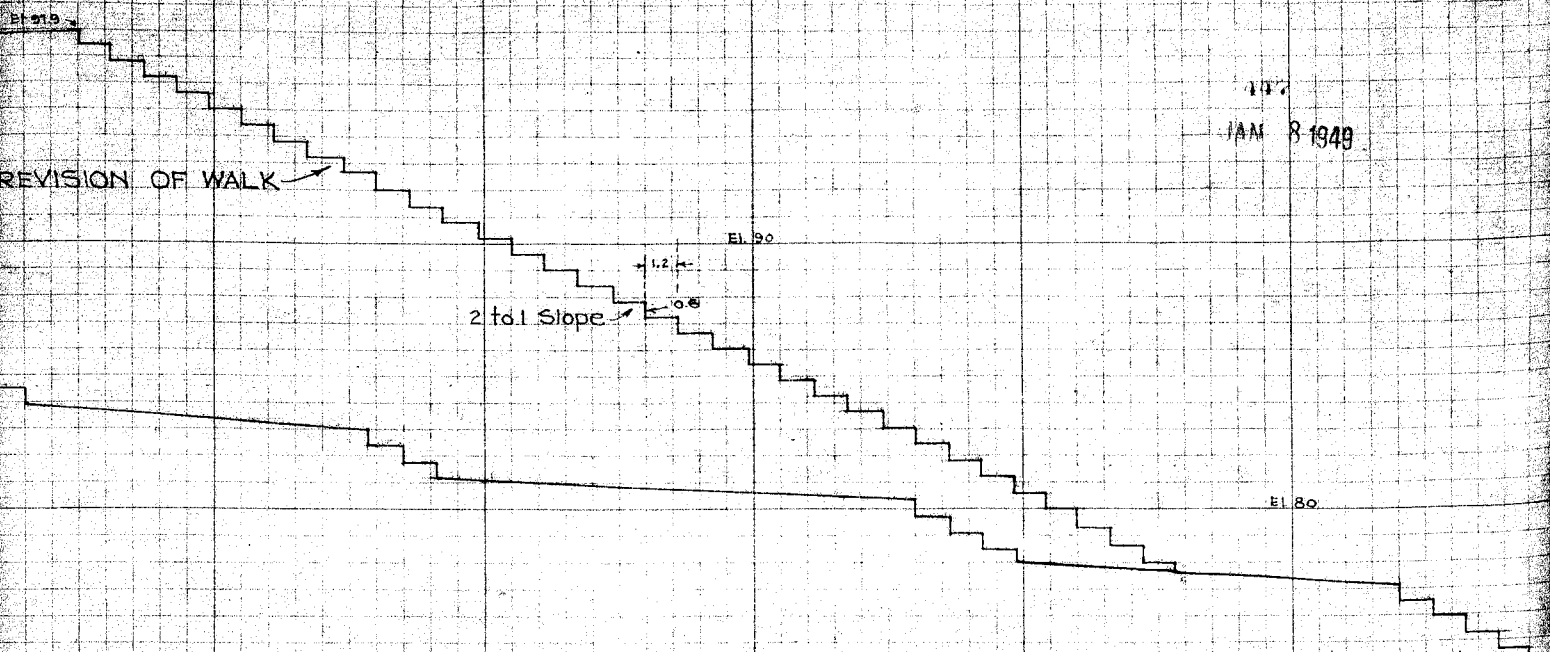

EXISTING WALKWAY LEADING FROM
S. MAIN ST. TO FURMAN UNIVERSITY
GREENVILLE S. C.

Hor. & Vert. Scale 1" = 4'
Aug. 1948

DALTON & NEVES

Recorded January 8th, 1949 at 11:01 A. M. #447