


REAR PORTION OF LOT 110-111-112

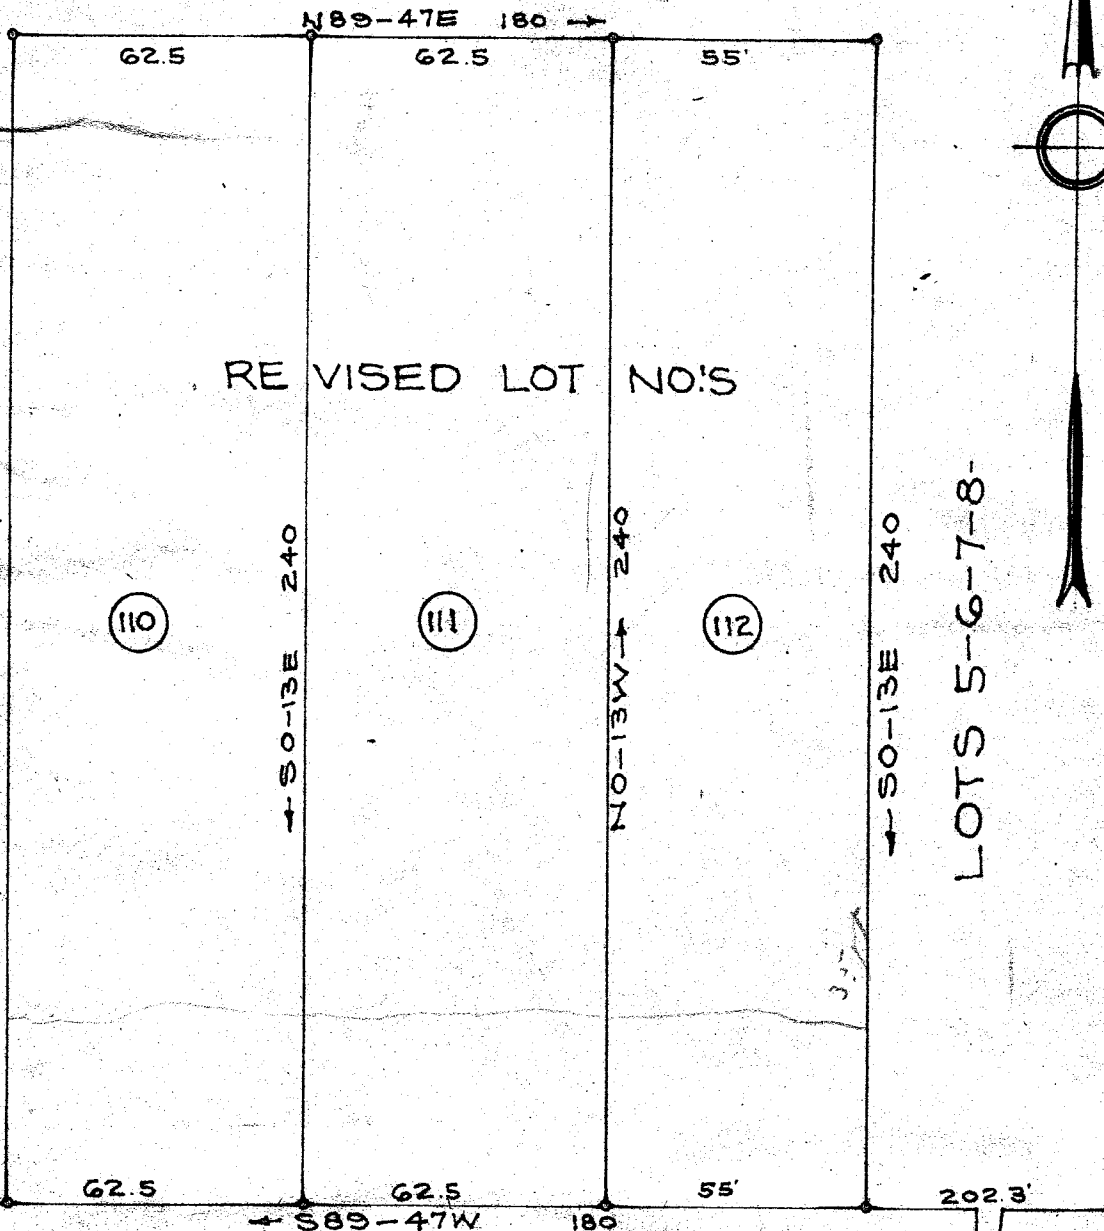

REVISED LOT NO'S

LOT NO. 109
NO-13W → 240

110

← S0-13E 240

111

NO-13W → 240

112

← S0-13E 240

LOTS 5-6-7-8-

62.5 62.5 55' 202.3'

BECK AVE.

OLD AUGUSTA ROAD

PROPERTY OF

B. H. TRAMMELL & C. E. ROBINSON JR.

GREENVILLE S. C.

Scale 1"=40' Jan. 1949

DALTON & NEVES

769

JAN 12 1949



769 ... 12 ... of Jan 10 49
 at ... 33 ...
 Ollie Farnsworth
 Register of Deeds Greenville Co