#6484½

MAR 21 1949

N-133

#648 Filed This 21 day of March 1949

And Recorded in Vol. V Page 125 at ..... M

Ollie Farnsworth

Register Mesne Conveyance Greenville County, S.C.

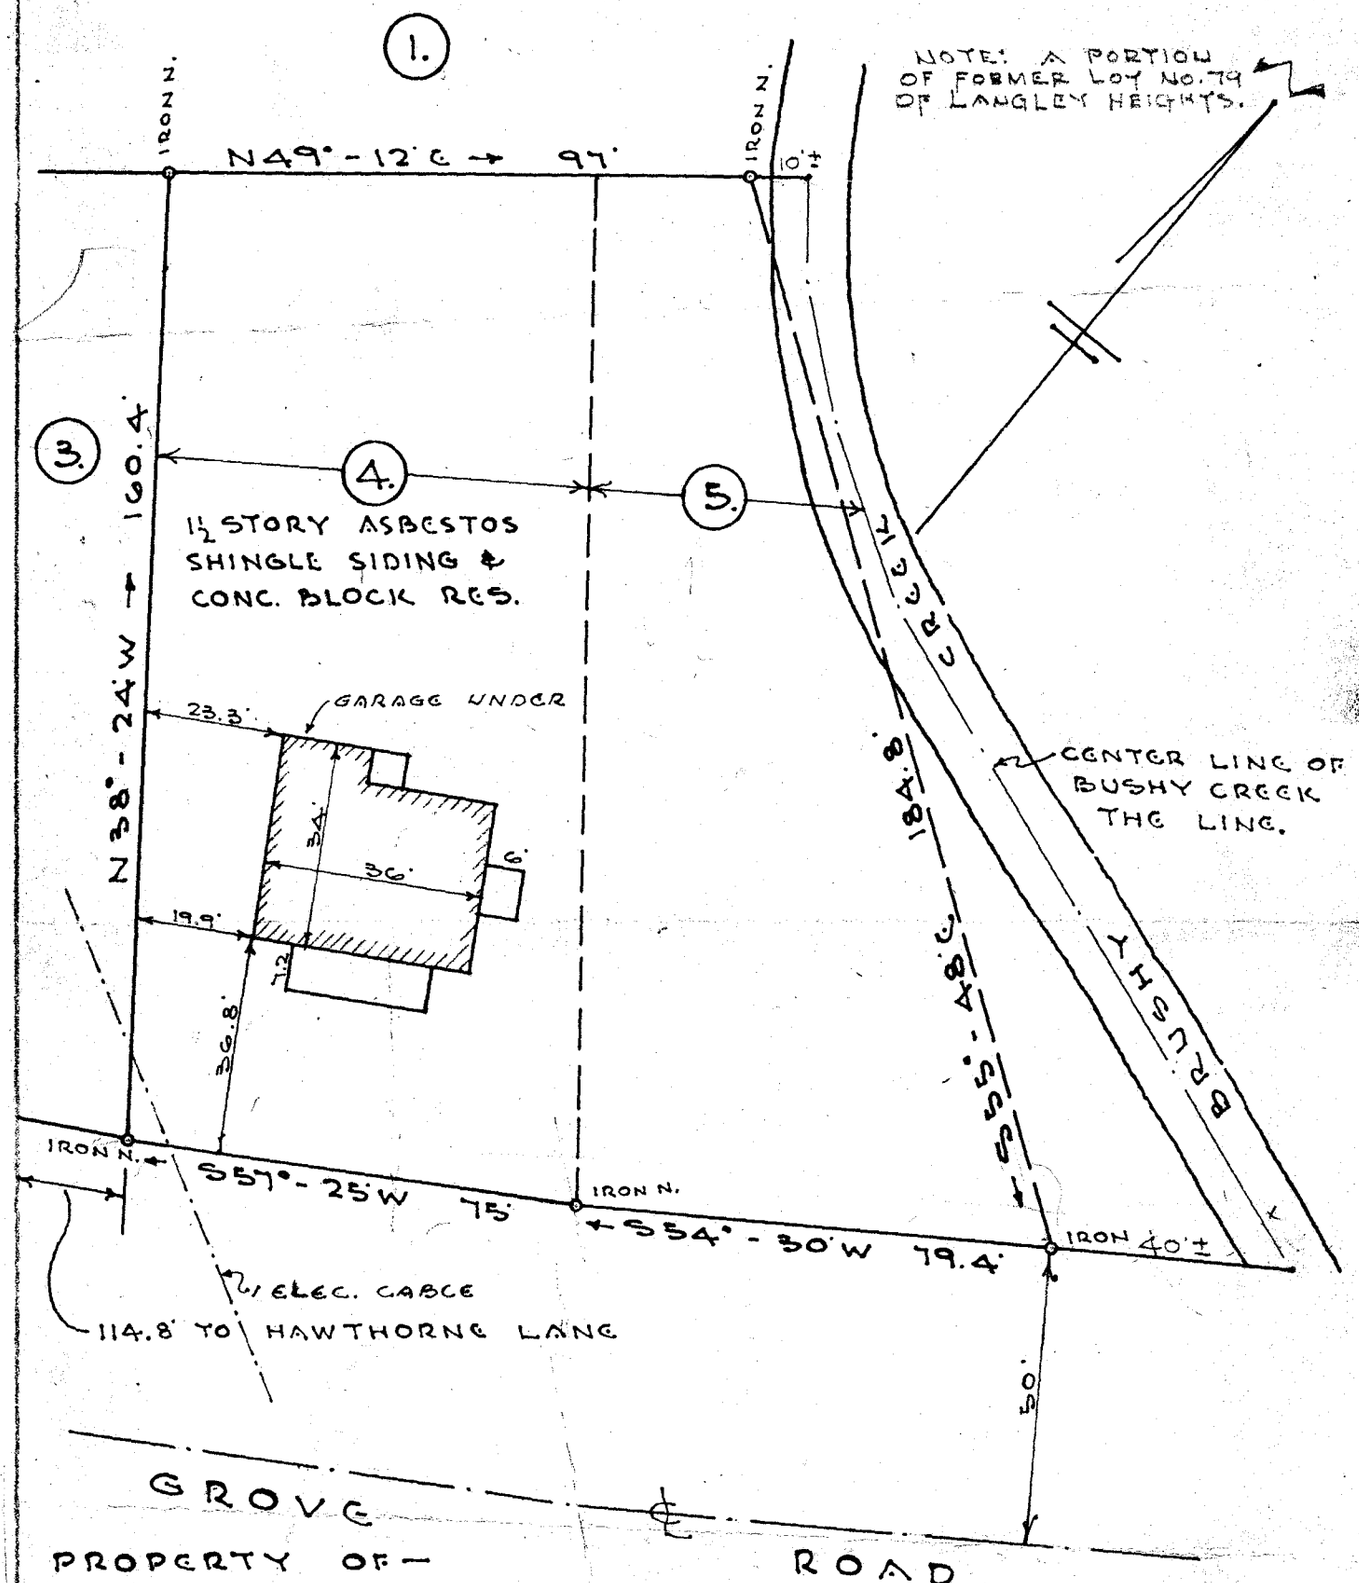

PROPERTY OF—

DOYLE S. PORTER.

LOCATED IN THE CITY OF GREENVILLE. S.C.

SCALE- 1" = 30' DATE - MAR. 3-1949

PICKELL & PICKELL. ENGINEERS
GREENVILLE. S.C.

I hereby certify that the measurements as shown on this plat are correct and there are no projections or encroachments other than shown.

Reg. Engr.