


# Plat Book-W-Page 171

FILED  
GREENVILLE CO., S.C.  
JAN 5 2 41 PM 1951  
OLLIE FARNSWORTH  
R. M.C.

See Plat K/125

70  
119.8

## BAD COPY

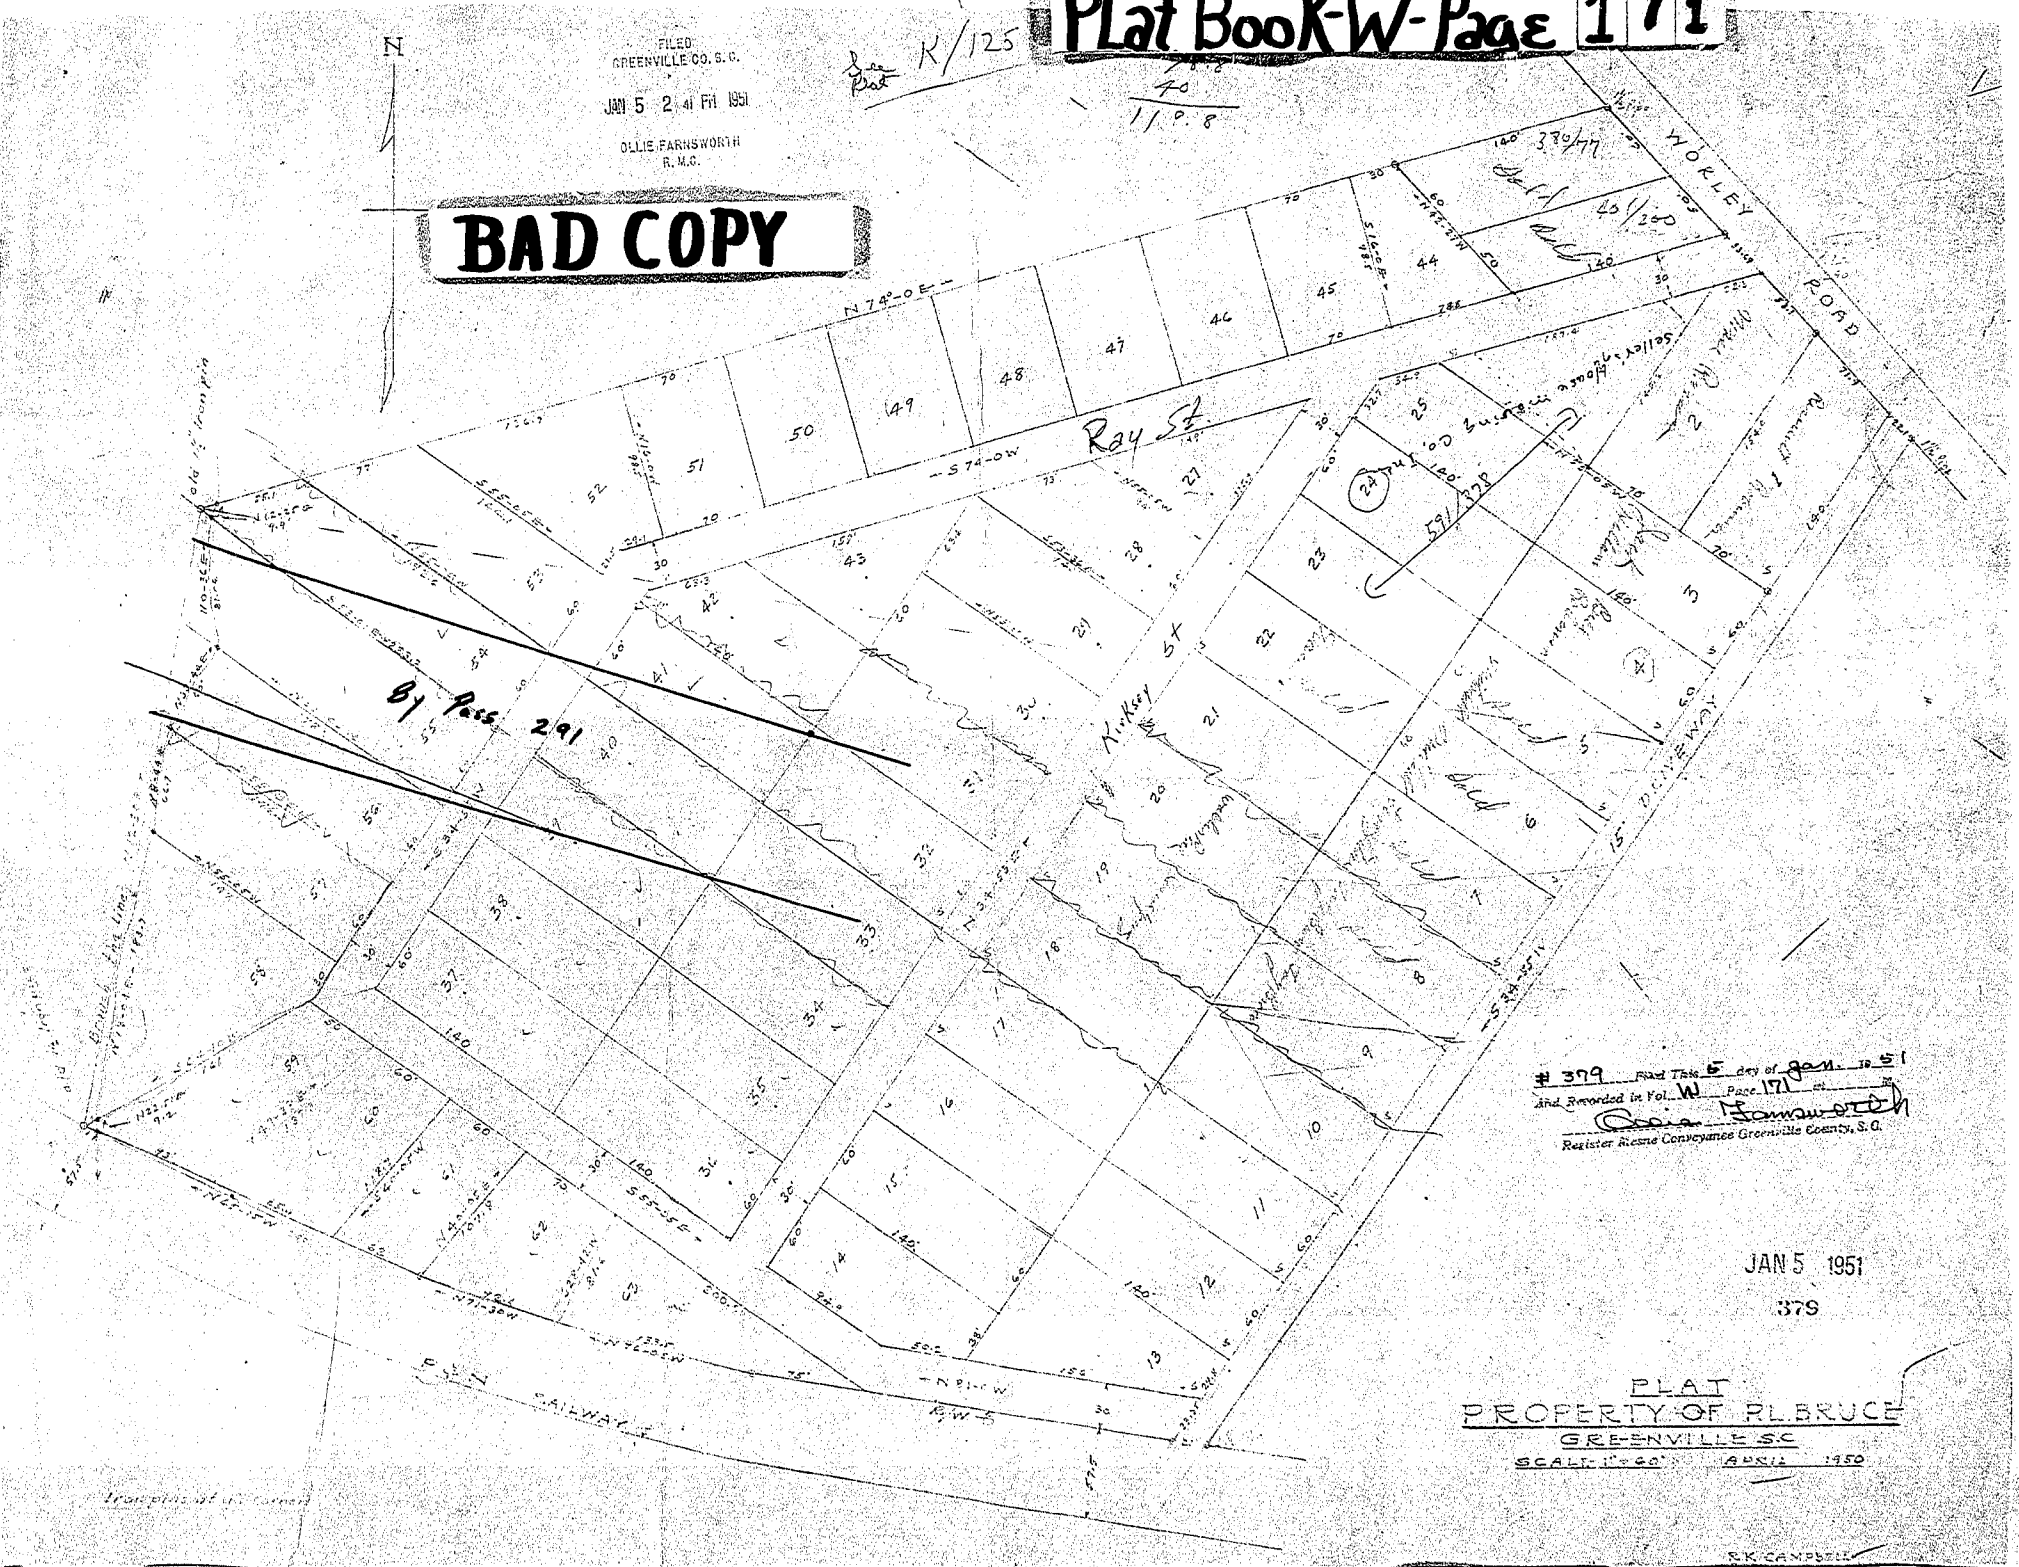

# 379 Plat Book W Page 171  
 and Recorded in Vol. W Page 171  
 Ollie Farnsworth  
 Register of Deeds Greenville County, S.C.

JAN 5 1951  
 379

PLAT  
 PROPERTY OF R. BRUCE  
 GREENVILLE SC  
 SCALE: 1"=60' APRIL 1950

RK CAMPBELL