
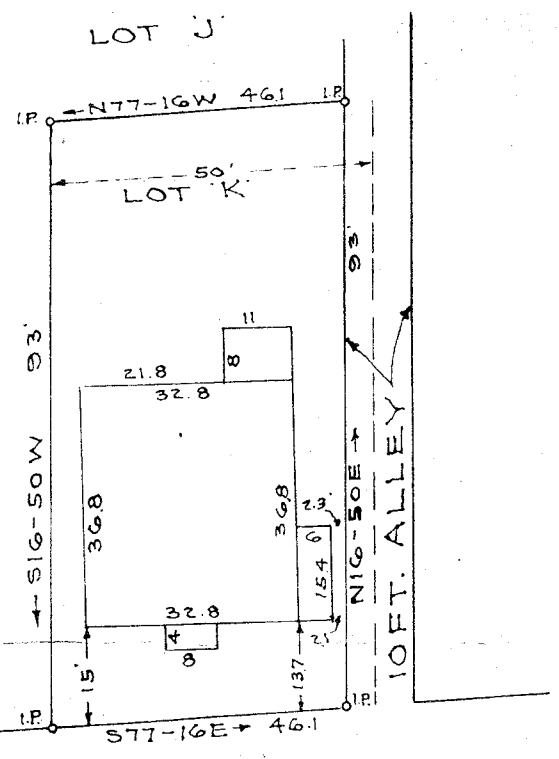


FILED  
 GREENVILLE S. C.  
 DEC 16 1949

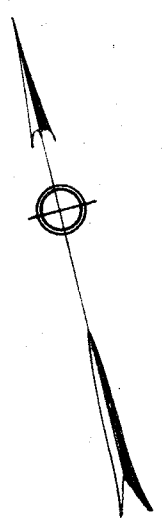

SO. CALHOUN ST.


LOT 'L'

DUNBAR ST.

29737  
 DEC 16 1949

PROPERTY OF  
 JOHN H. PITTS  
 GREENVILLE S. C.  
 Scale 1"=30' Nov. 1949

This is to certify that on the 11th day of November, 1949, I surveyed the property shown on this plat; being known as Lot K as shown on plat of Greenville Trust Co., Recorded in Plat Book C page 13 Office of R. M. C. Greenville Co., S. C.; and that the property lines, walls and buildings are as shown hereon; that the buildings located on said lot do not encroach or project on adjacent streets or property; and that no adjacent buildings or walls encroach or project on said premises.

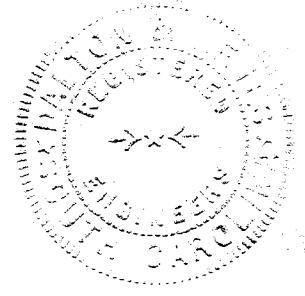

*B. W. Walton*  
 Registered L. S.

29737 Filed This 16 day of Dec- 49  
 And Recorded in Vol. 7 Page 17 at 11:30  
*Reeie Farnsworth*  
 Register in Charge Conveyance Greenville County, S. C.