S/183
K/81-82

#23496 Filed This 27 day of Sept 1950
and Recorded in Vol. Y Page 53 at 11:56 M.
Gossie Farnsworth
Register Mesne Conveyance Greenville County, S. C.

Respondent's Exhibit B

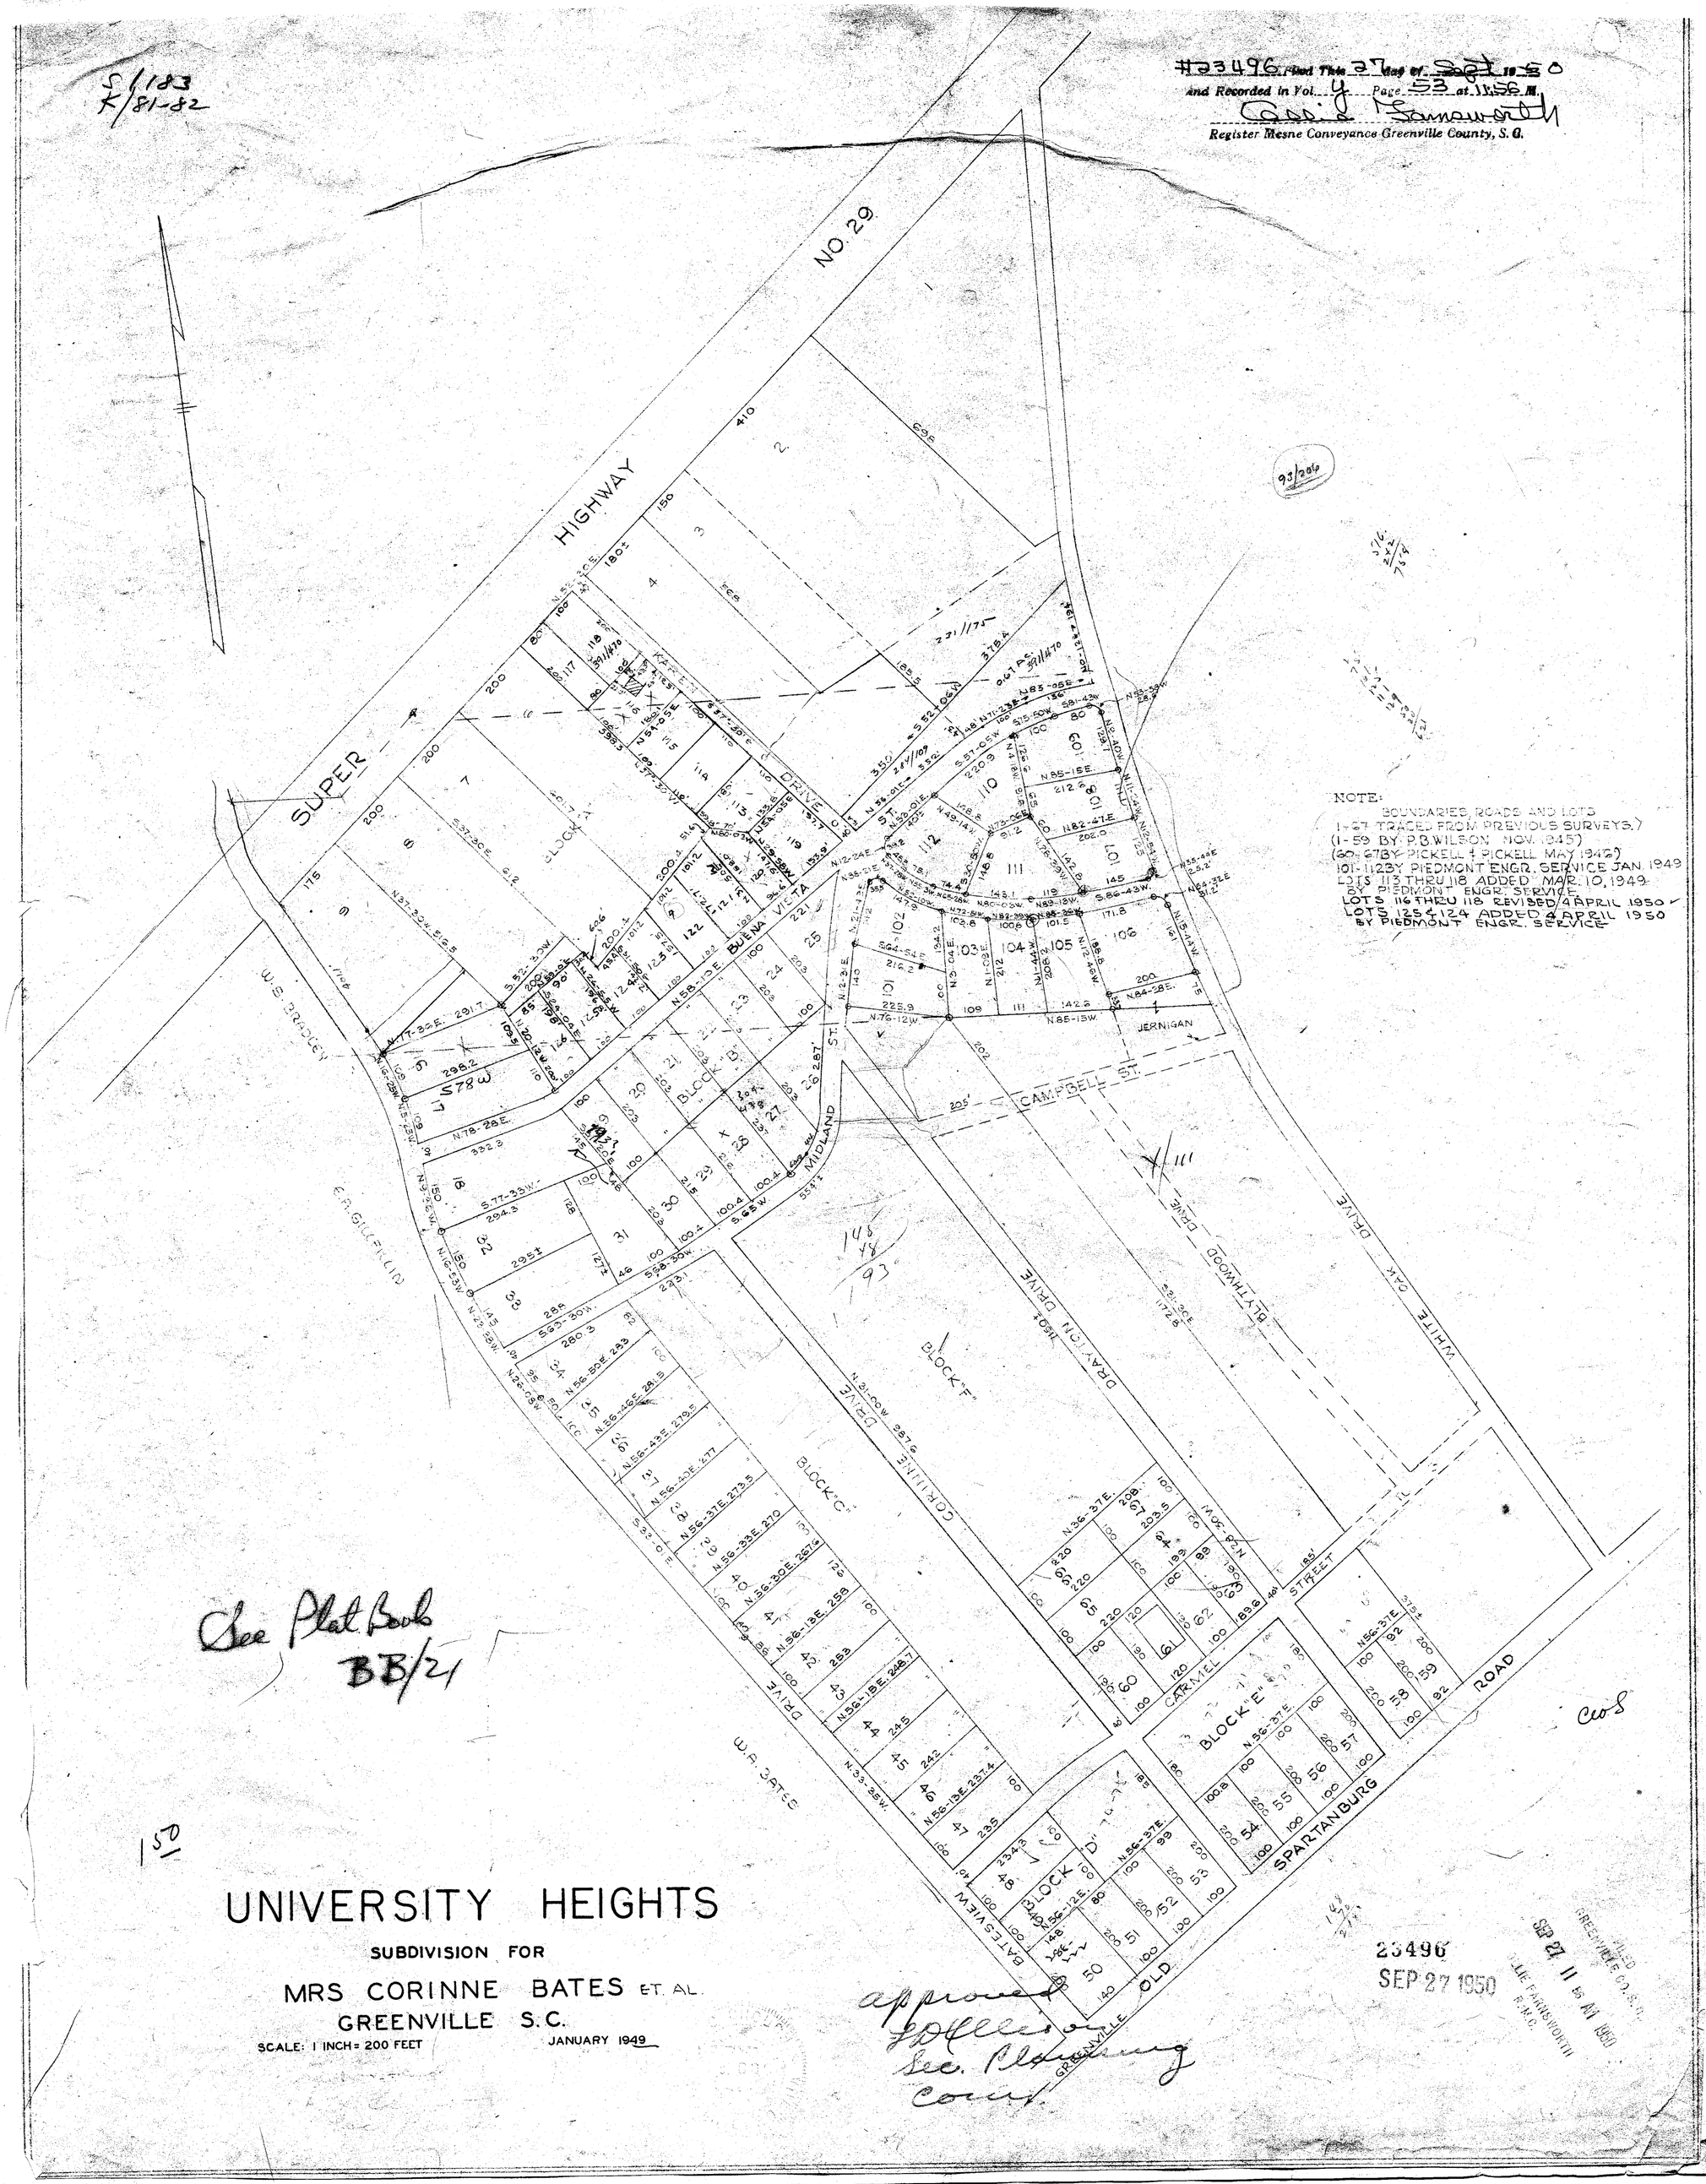

NOTE:
BOUNDARIES, ROADS AND LOTS
1-67 TRACED FROM PREVIOUS SURVEYS.)
(1-59 BY P.B. WILSON NOV. 1945)
(60-67 BY PICKELL & PICKELL MAY 1946)
101-112 BY PIEDMONT ENGR. SERVICE JAN. 1949
LOTS 113 THRU 118 ADDED MAR. 10, 1949
BY PIEDMONT ENGR. SERVICE
LOTS 116 THRU 118 REVISED 4 APRIL 1950
LOTS 125 & 124 ADDED 4 APRIL 1950
BY PIEDMONT ENGR. SERVICE

See Plat Book BB/21

150

UNIVERSITY HEIGHTS

SUBDIVISION FOR

MRS CORINNE BATES ET. AL.

GREENVILLE S.C.

SCALE: 1 INCH = 200 FEET JANUARY 1949

approved
L D Allison
Sec. Planning
Comm.

23496
SEP 27 1950

FILED
GREENVILLE CO. S.C.
SEP 27 11 56 AM 1950
OLLIE FARNSWORTH
R.M.C.