
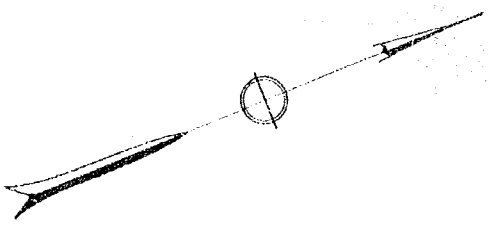


AUGUSTA CIRCLE

IP - S21-35W 60 IP

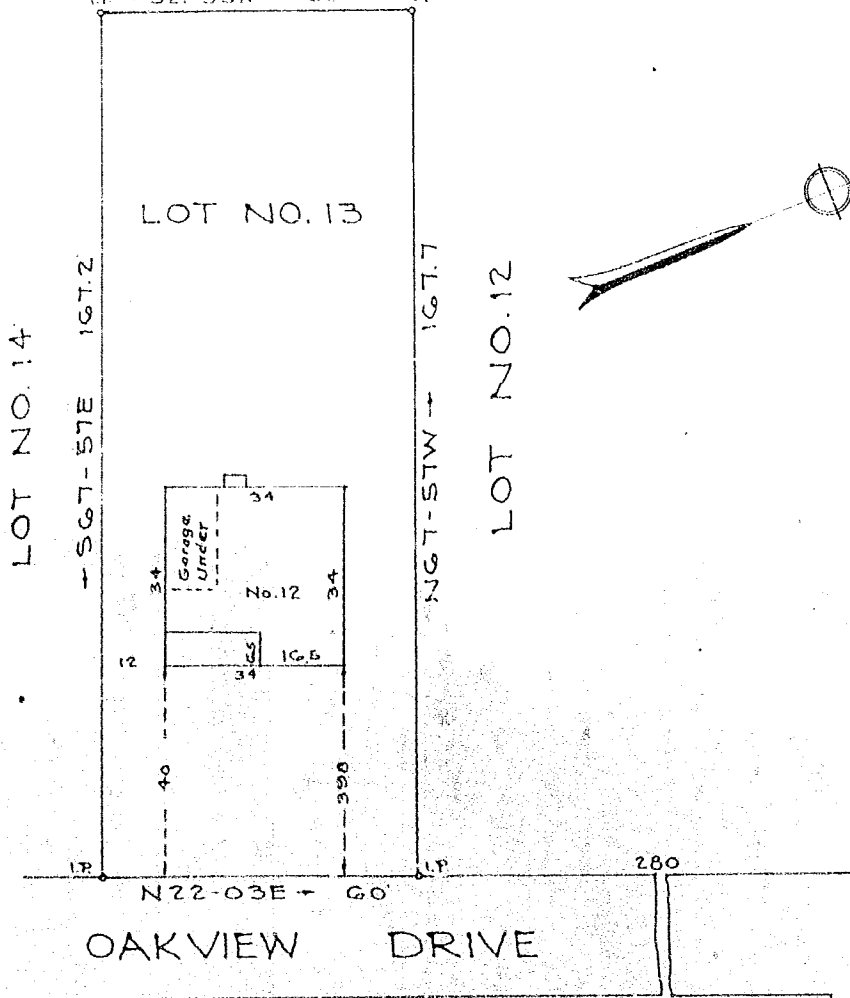

AUGUSTA DRIVE EAST

OAKVIEW DRIVE

PROPERTY OF
 EDGAR ODOM
 GREENVILLE, S. C.
 Scale 1"=30' Nov. 1950

FILED
 GREENVILLE CO. S. C.
 NOV 8 11 48 AM 1950
 OLIVE FARNSWORTH
 R. M. C.

This is to certify that on the 6th day of November, 1950, I surveyed the property shown on this plat; being known as Lot No. 13 according to a plat recorded in Plat Book Z page 73, Office of R. M. C. Greenville Co., S. C.; and that the property lines, walls and buildings are as shown hereon; that the buildings located on said lot do not encroach or project on adjacent streets or property; and that no adjacent buildings or walls encroach or project on said premises.

R. W. Dutton
 Registered

27117

NOV 8 1950

#27117
 And Recorded in Plat Book Z page 73 at 11:46 AM
 Oliver Farnsworth
 Registrar Greenville County, S. C.