#4837 Filed this 27 day of Feb 1952
And Recorded in Z - 92 at ..... M.
Register Mesne Conveyance Greenville County, S. C.

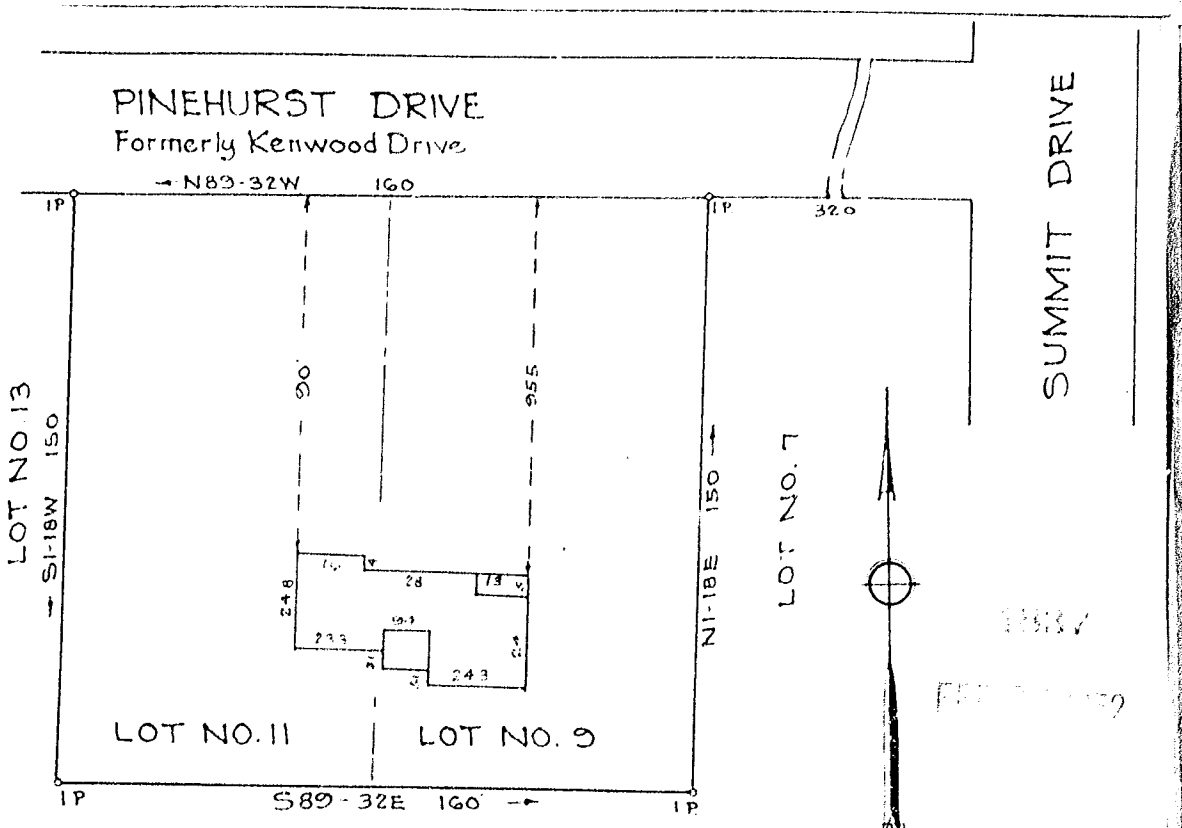

PROPERTY OF
SIDNEY L. LOWE
EUNICE C. LOWE
GREENVILLE S. C.
Scale 1"=40 Feb 1952

This is to certify that on the 22nd day of February, 1952, I surveyed the property shown on this plat; being known as Lots 9-11 of Kenwood Place as shown on plat recorded in Plat Book Z page 92, Office of R. M. C. Greenville Co., S. C.; and that the property lines, walls and buildings are as shown hereon; that the buildings located on said lot do not encroach or project on adjacent streets or property; and that no adjacent buildings or walls encroach or project on said premises.

R. E. Patton
Registered.

BAD COPY