


#20869 Filed This 21 day of Sept. 1953

And Recorded in Vol. 77, Page 1865

W. W. Dalton
Register of Deeds Greenville County, S. C.

SEP 21 10 17 AM 1953

R. M. C.

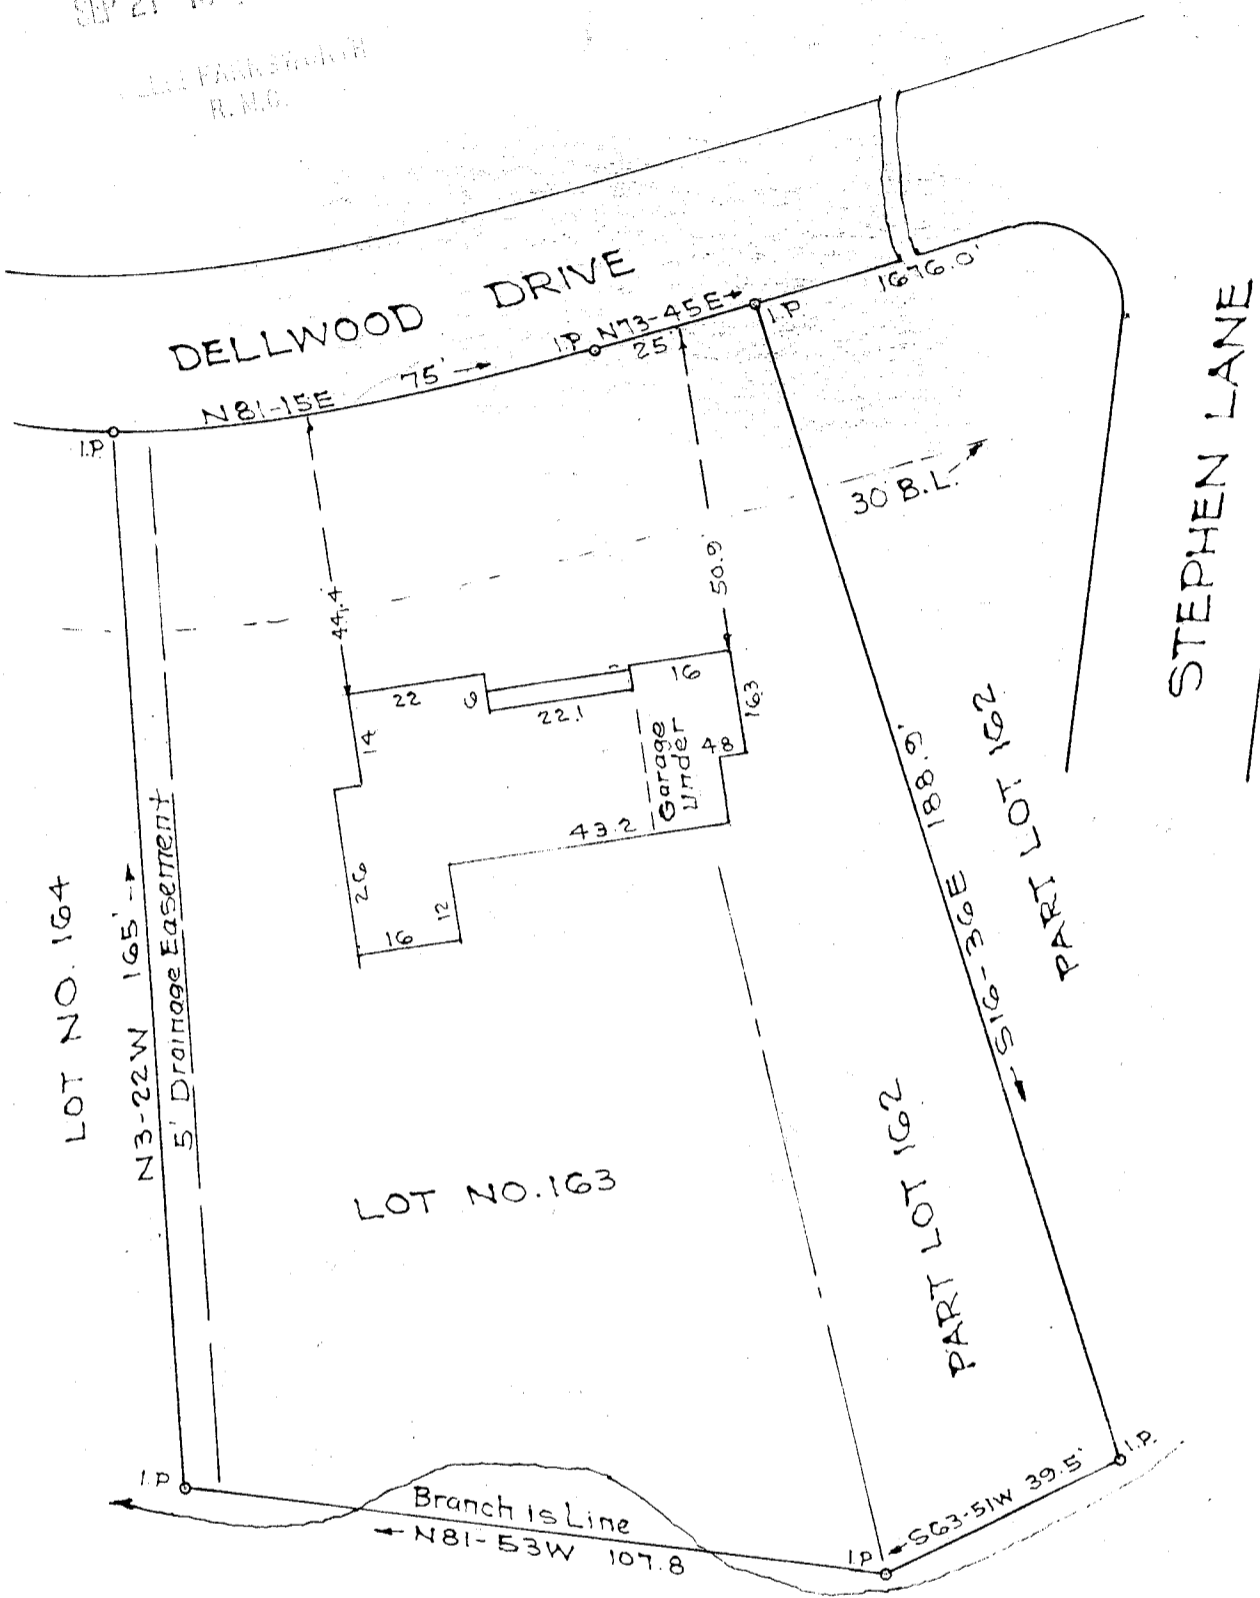

PROPERTY OF
 F. D. FINLEY
 GREENVILLE S. C.
 Scale 1"=30' Sept. 1953

20869
 SEP 21 1953

This is to certify that on the 11th day of September, 1953, I surveyed the property shown on this plat; being known as Lot No. 163 and part of Lot No. 162 on plat of Central Development Corporation, Recorded in Plat Book BB, pages 22-23, Office of R. M. C. Greenville Co., S. C.; and that the property lines, walls and buildings are as shown hereon; that the buildings located on said lot do not encroach or project on adjacent streets or property; and that no adjacent buildings or walls encroach or project on said premises.

W. W. Dalton
 Registered.