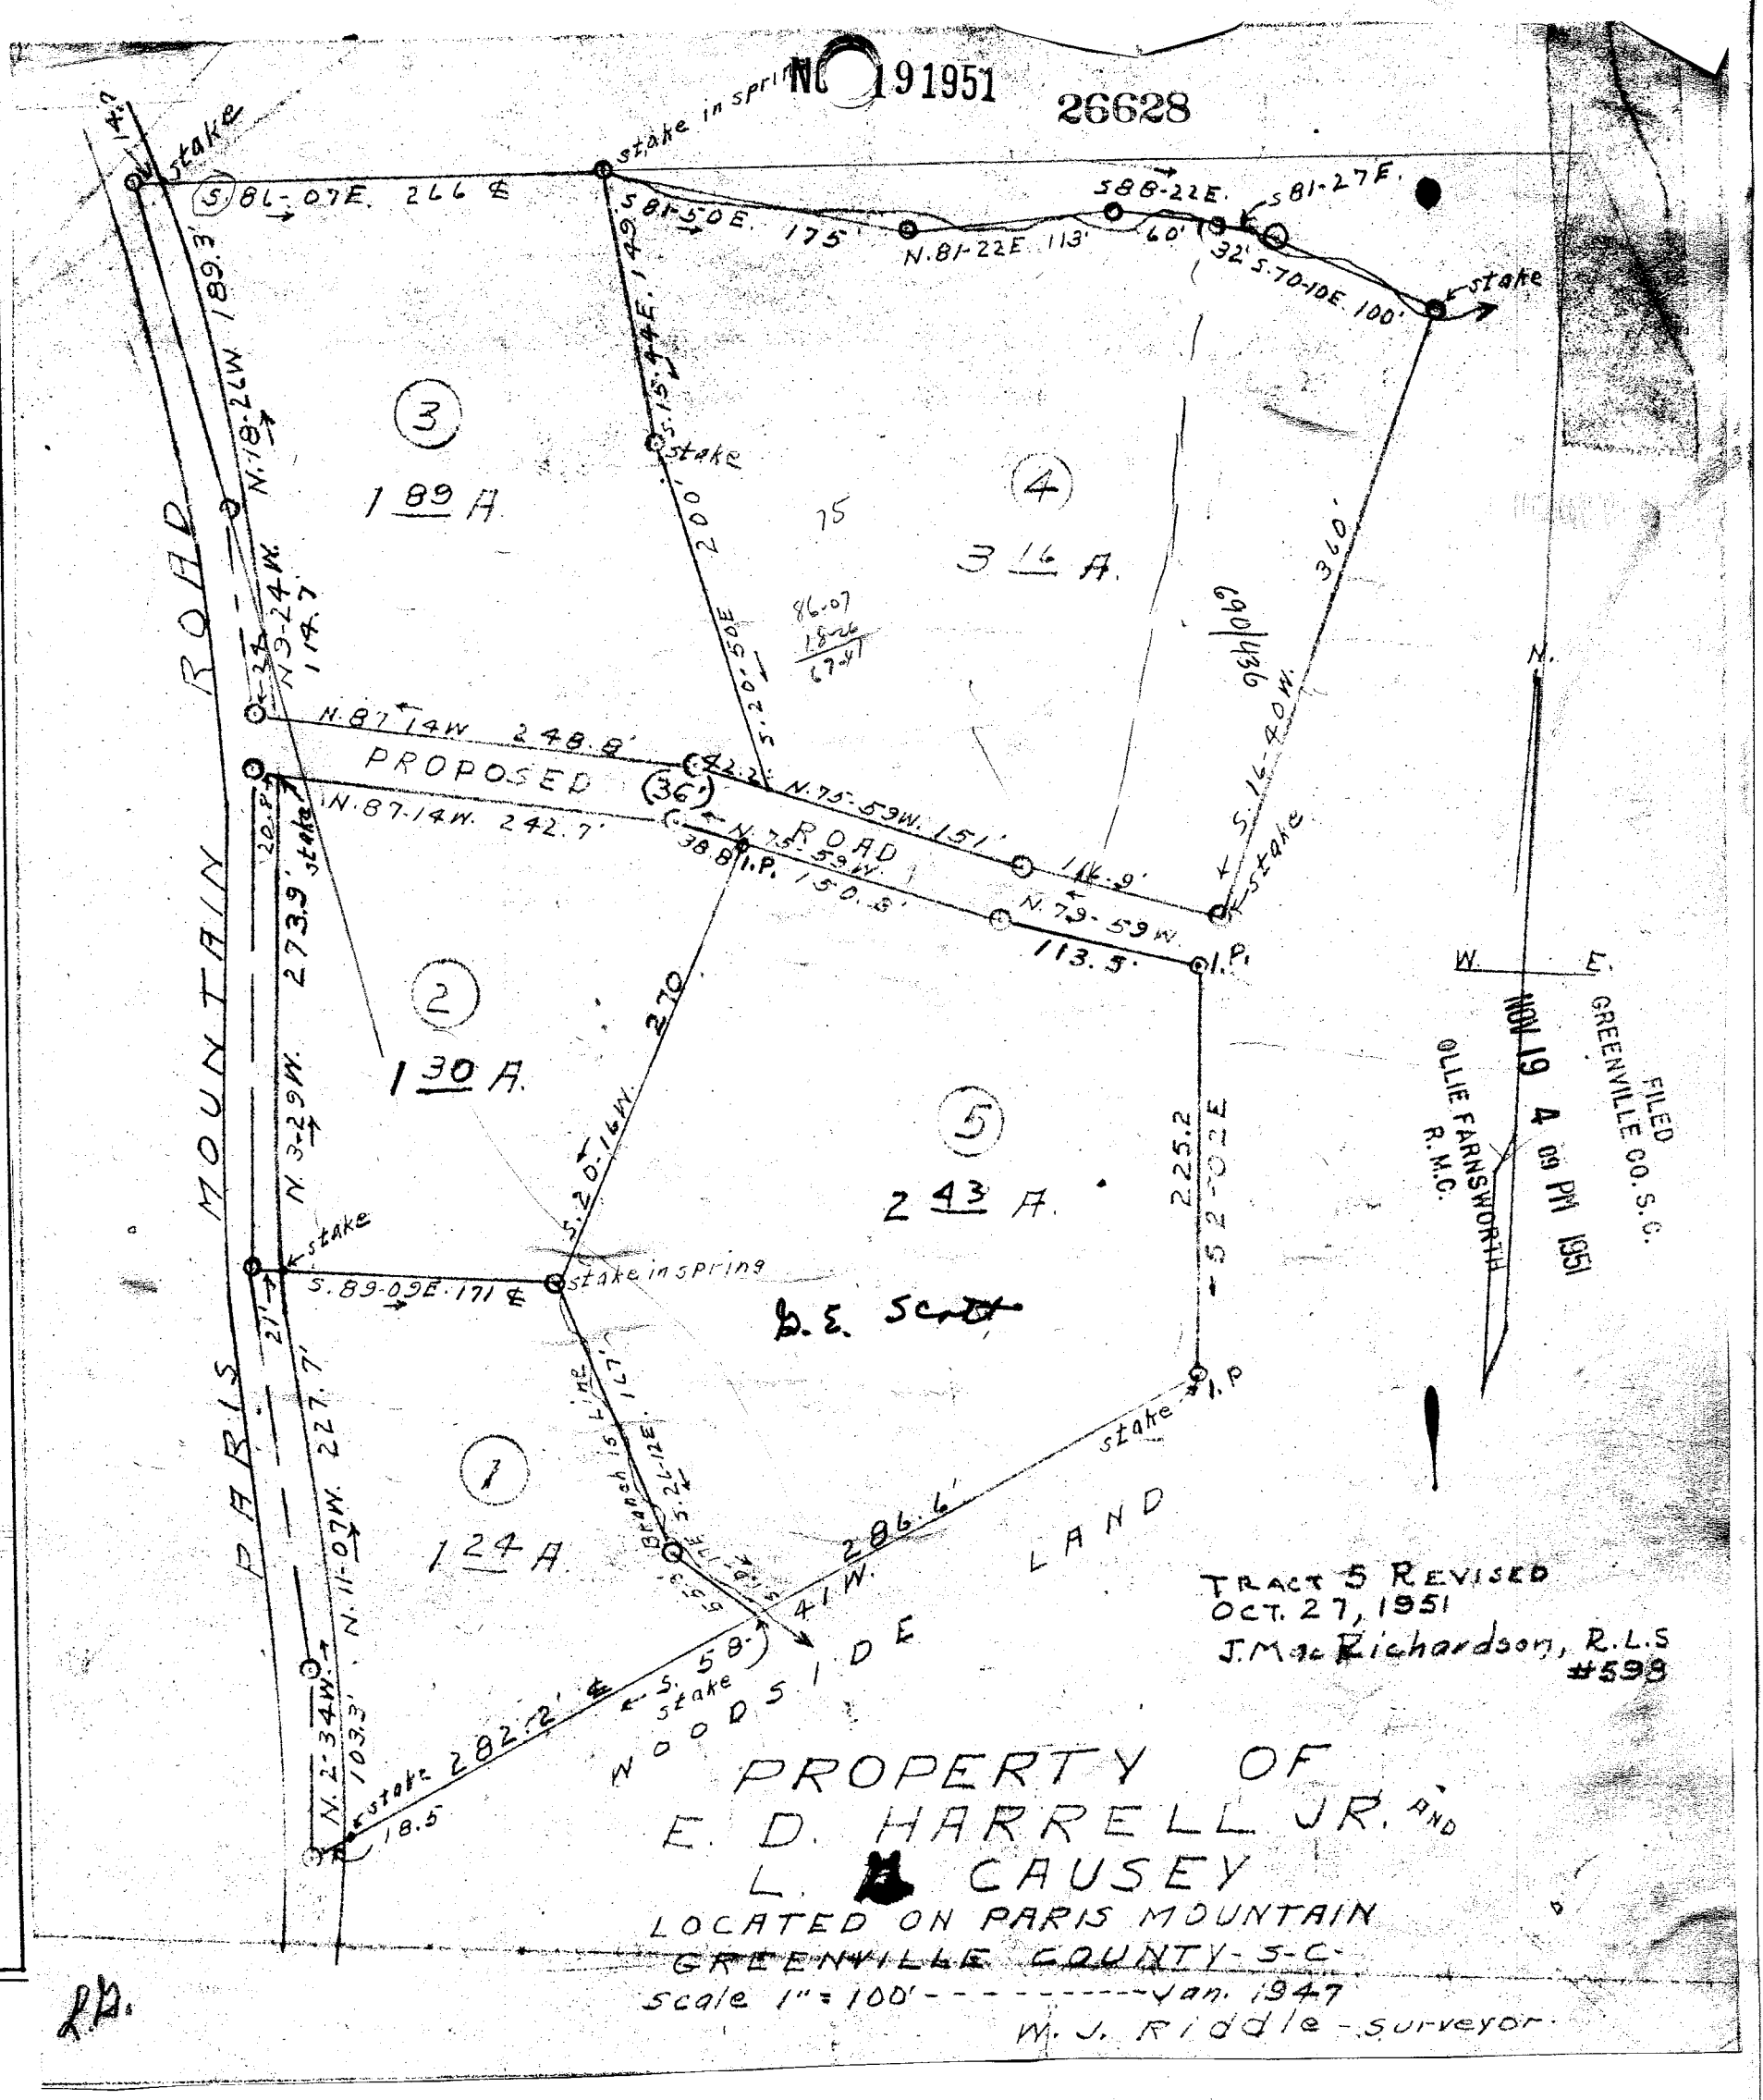

#26628 Filed This 19 day of Nov. 1951
And Recorded in Vol. A A Page 195 at M.
Ollie Farnsworth
Register Mesne Conveyance Greenville County, S. C.