


FILED
GREENVILLE CO. S. C.

JUL 25 1 40 PM 1952

OLLIE FARNSWORTH
R. M. C.

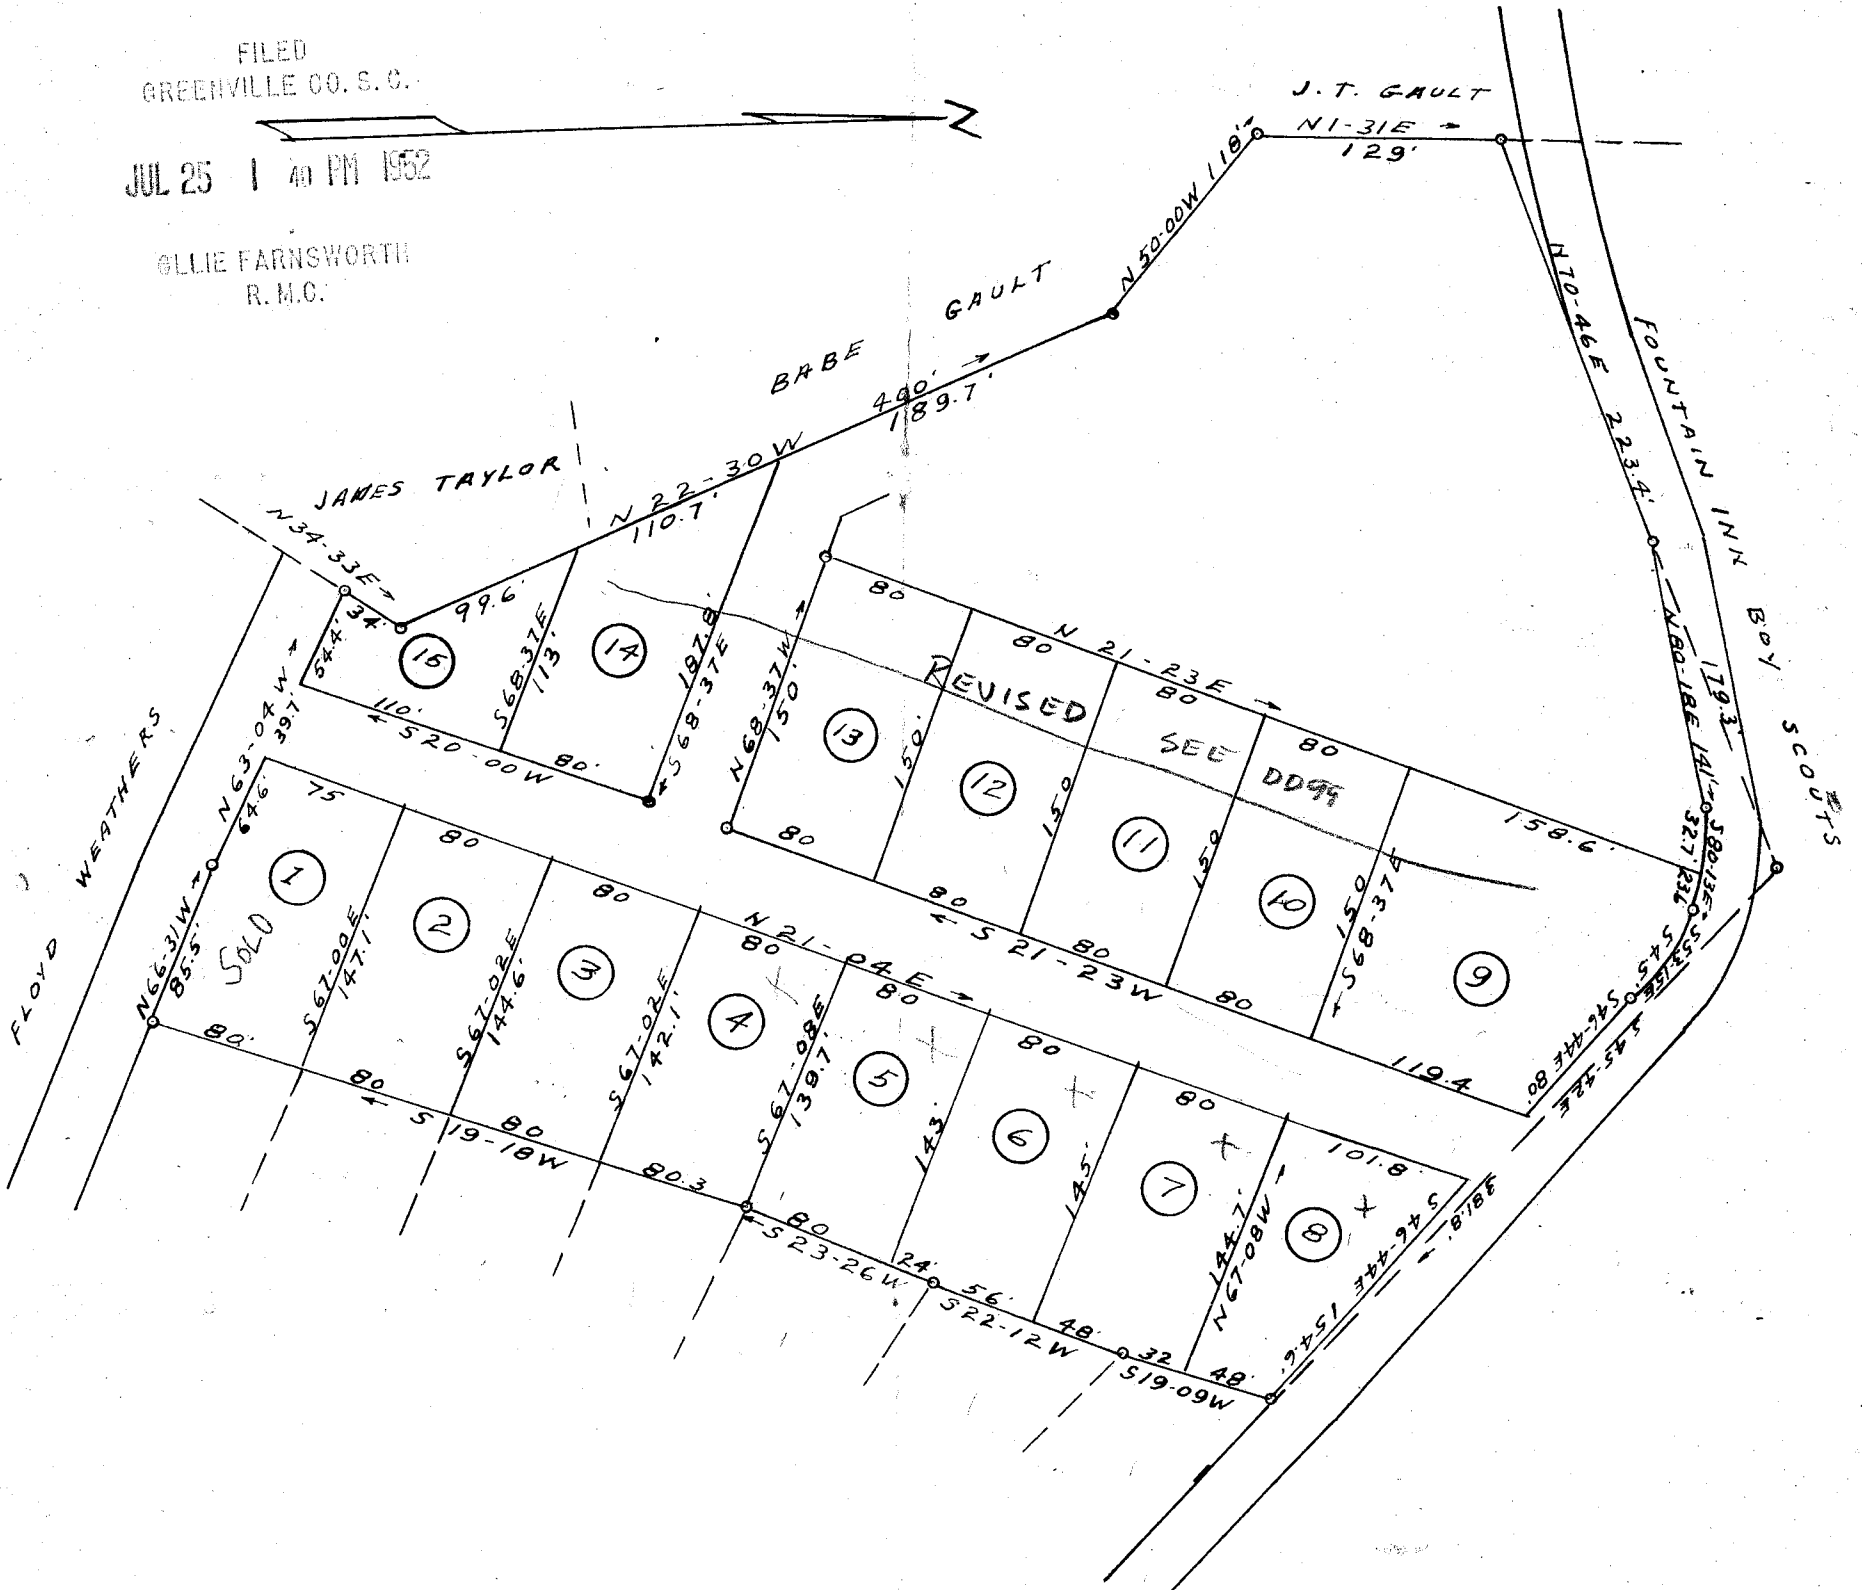

PROPERTY OF
FLOYD & MARY W. WEATHERS

FOUNTAIN INN S. C.

SCALE 1" = 100'

MAR. 28, 1952

16458

JUL 25 1952

Book A-52

W. J. Riddle Surveyor

#16458 Filed This 25th day of Aug. 1952
 And Recorded in Vol. 60 of 140 P.M.
 Ollie Farnsworth
 Register Mesne Conveyance Greenville County, S. C.