


FILED
GREENVILLE CO. S.C.

AUG 18 5 17 PM 1952

OLLIE FARNSWORTH
R.M.C.

N

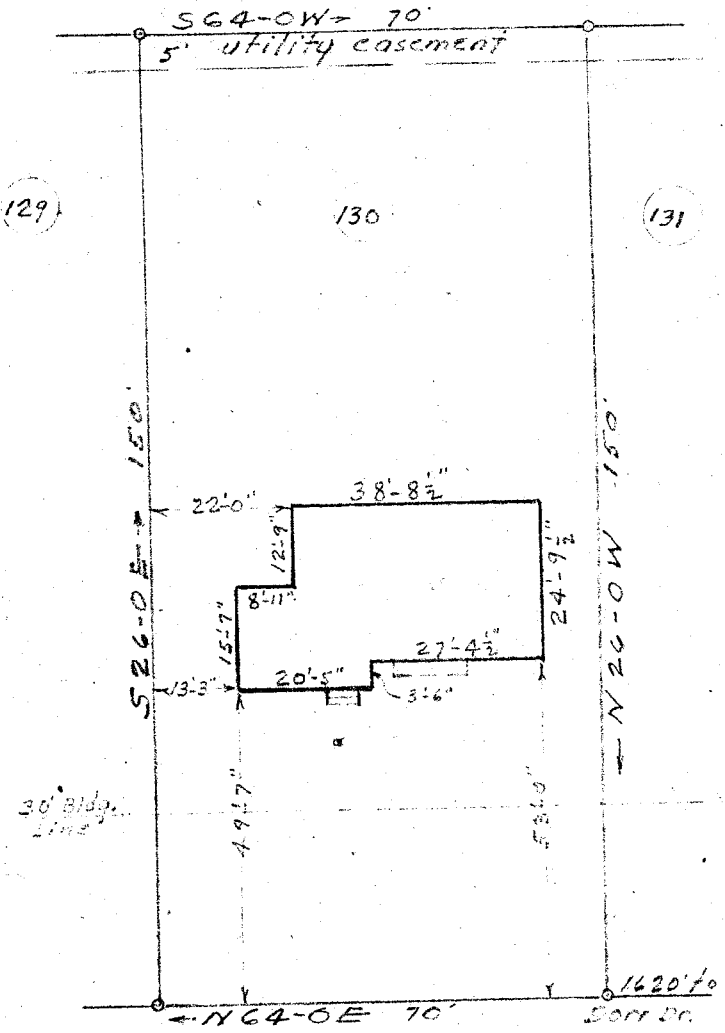

CROSBY CIRCLE

This is to certify that on Aug, 18, 1952 I surveyed Lot No. 130 of Paramount Park, filed in R.M.C. Office for Greenville County in Plat Book "W" at Page 57, and that the property lines, walls and buildings are as shown hereon that the buildings located on said property do not encroach or project on adjacent streets or property, and that no adjacent walls or buildings encroach or project on said premises.

Surveyed by R. Campbell

S.C.Reg. No. 996

18316

AUG 18 1952

PROPERTY OF
WILLIAM T. JOHNSON
NEAR GREENVILLE S.C.
SCALE 1" = 30' AUG 8, 1952

#18316 Filed the 18 day of Aug. 1952

And Recorded in Vol. CO Page 123 of

OLLIE FARNSWORTH

Register Mesne Conveyance Greenville County, S. C.