


# Plat Book 88 Page 155B

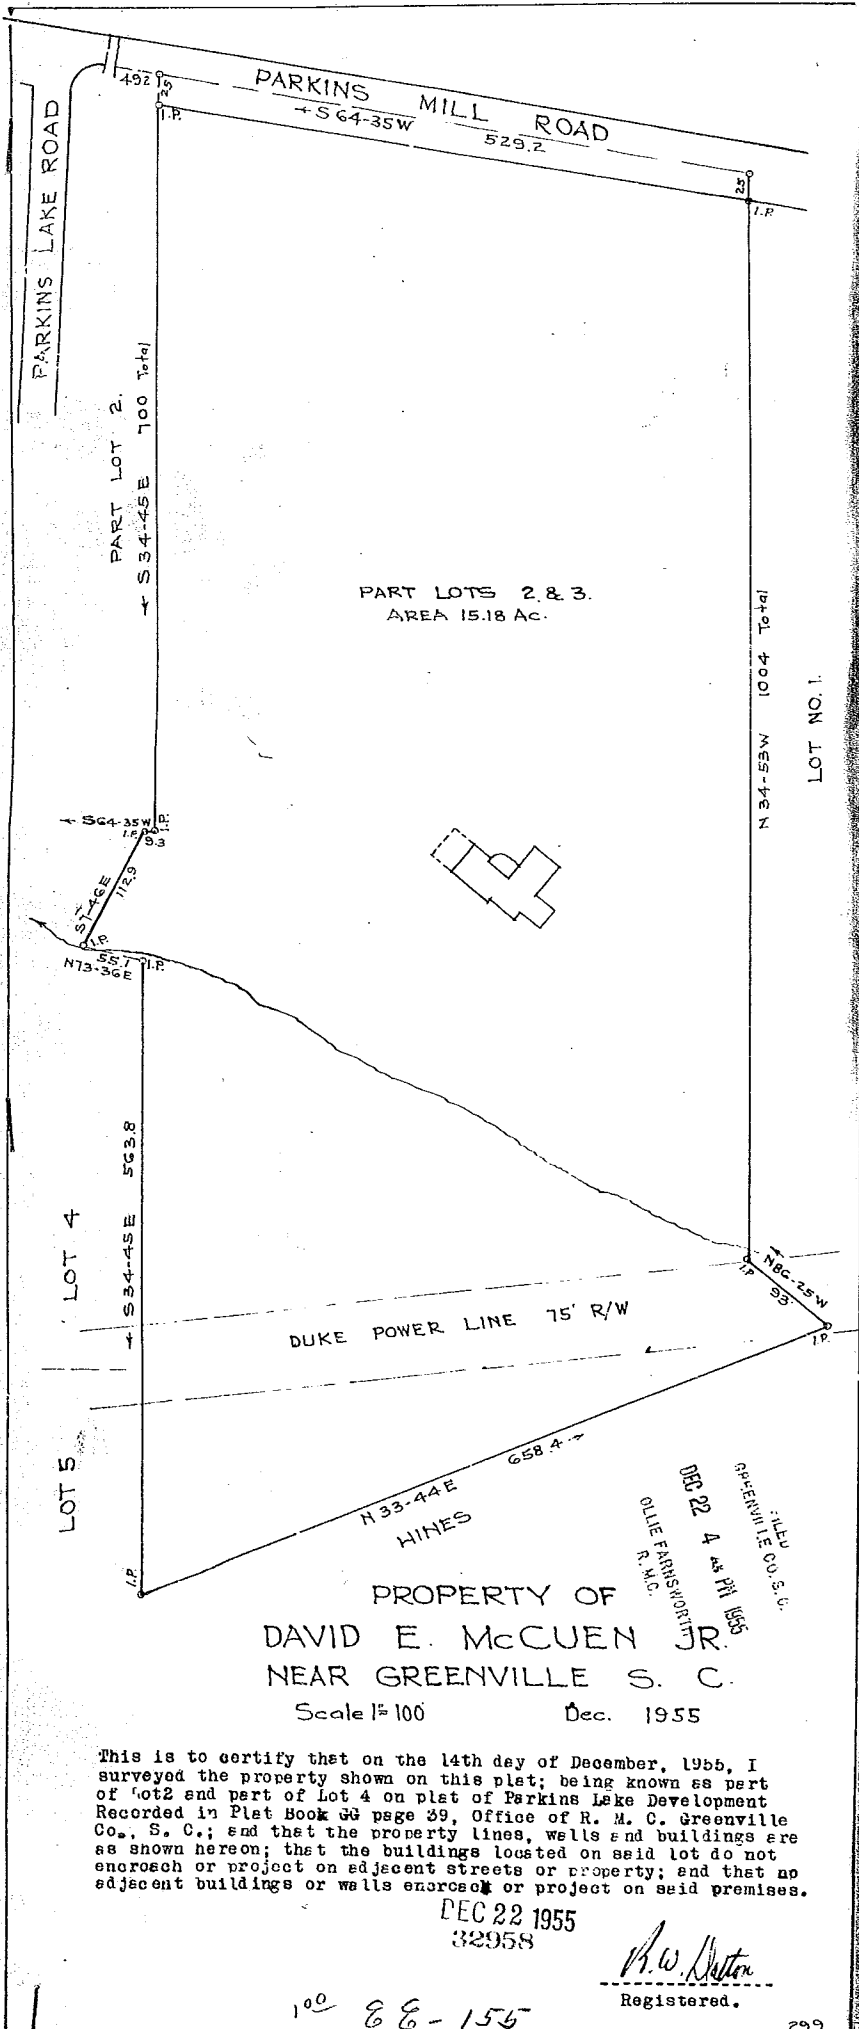

M. C. Greenville Co., S. C.; and that the property lines, wells and buildings are as shown hereon; that the buildings located on said lot do not encroach or project on adjacent streets or property; and that no adjacent buildings or walls encroach or project on said premises.

DEC 22 1955  
32958

*R. W. Norton*  
Registered.

100 88-155

32958  
