

JUL 16 1953

15912


P. & M. Co.—25M—10-52

Form 63—Rev. 10-52

DUKE POWER COMPANY

WORK ORDER FOR \$500.00 OR LESS

County GREENVILLE Branch GREENVILLE Work Order No. 2-1244
 Township GREENVILLE Dist. or Town SIGNAL Order Made By H.M.S.
 School District WELDON Urban _____ Date Made 7-1-53
 Est. Cost \$ _____ Suburban _____ Prim. Circuit 34KV-A
 Est. Revenue \$ _____ Rural _____ Substation GREENVILLE
 To Be Known As ROBERT HUNT

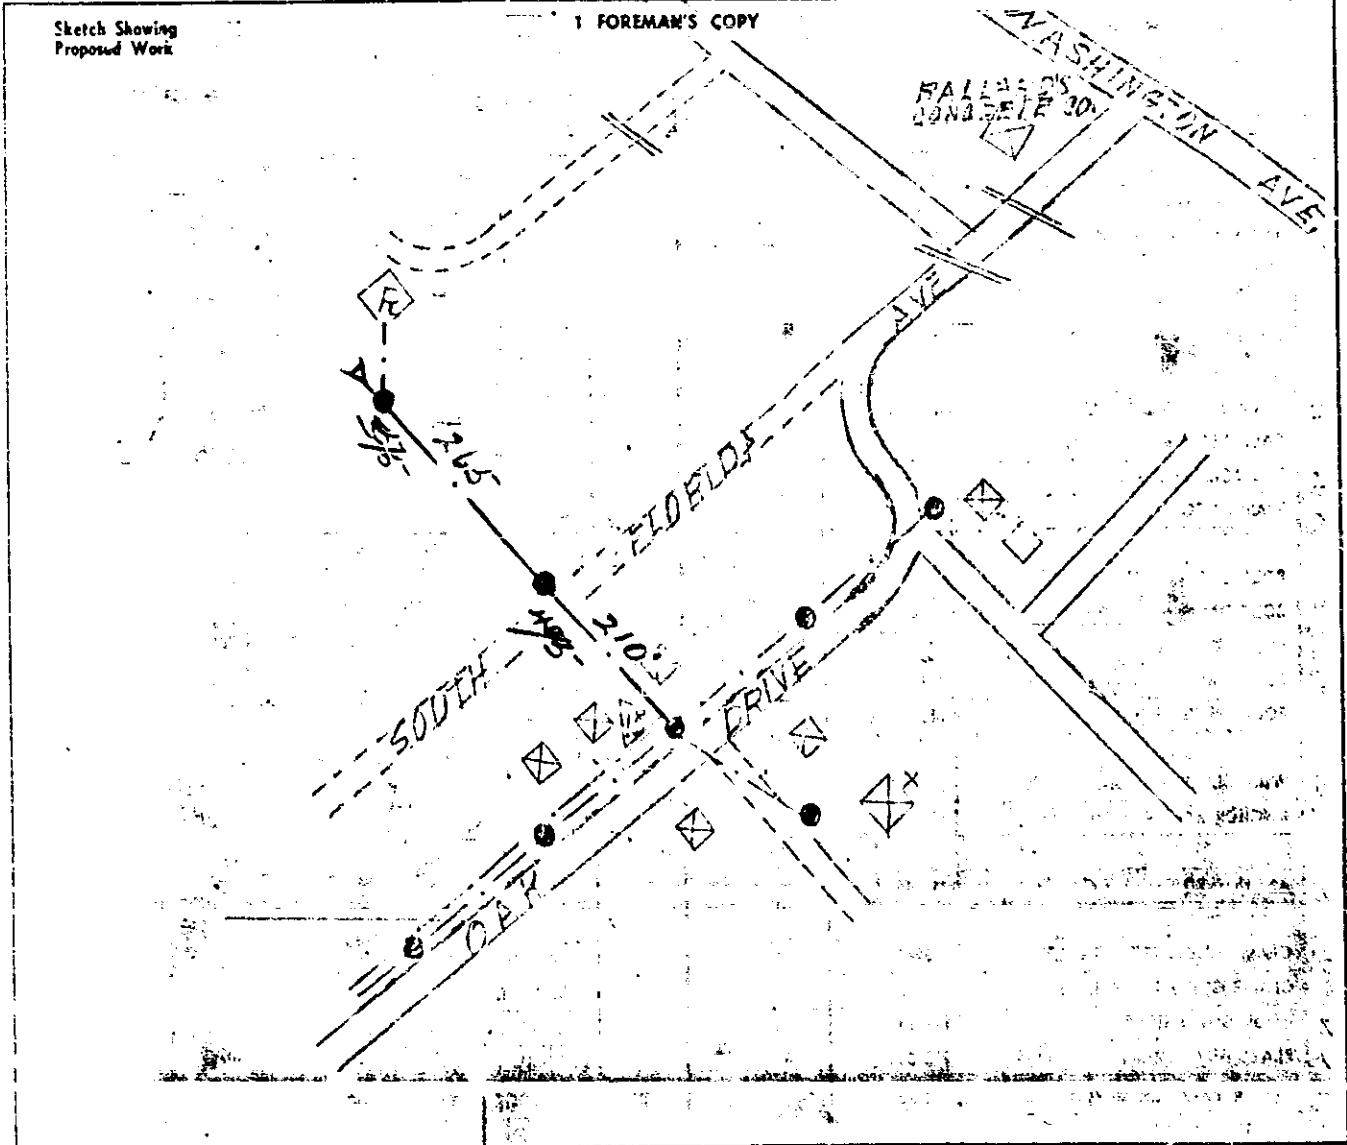

Total Pole Line Miles Extension _____ Primary Miles _____ Secondary Miles _____
 Remarks 11-1-10'-1-35' SPANS
5-31-53, SPANS
 Approved _____ Date _____
 Approved _____ Date _____
 Branch Mgr. _____ Date _____
 Date Issued _____
 Date Completed _____

JUL 16 10 41 AM 1953
 THE PANNSYRANIA
 R. H. C.
 GREENVILLE CO. S.C.

Recorded July 16th, 1953 at
 10:41 A. M. #15912